IREDELL COUNTY HEALTH DEPARTMENT

STATESVILLE 704-878-5305 MOORESVILLE 704-664-5281

IMPROVEMENT PERMIT / AUTHORIZATION TO CONSTRUCT / OPERATION PERMIT / EXISTING SYSTEM INSPECTION

PERMIT# REPAIR PIN# 4713-87-8914 DATE 1-30-07

OWNER OR APPLICANT CAMELLA & MICHAEL SNOUSE PHONE: Business 704-873-4475 Home 704-252-0629 /3

ADDRESS US 70 WEST TL BETHLEHEM ROAD TL GREENWICH DR, 1ST DRIVE ON LEFT

LOCATION 387 BETHLEHEM RD, STATESVILLE, NC 28677

SUBDIVISION THE LANDINGS BLOCK / SECTION 1 LOT 5 LOT AREA 0.56 ACRE SITE CLASS. PS DESIGN FLOW 360 L.T.A.R. EXISTING 0.30 GPD/FT2

Septic Tank: EXISTING Gallons; STB Date

Pump Tank: Gallons; PT Date

Pump Make: Model Serial No.

Nitrification Field: No Fields 1 Square Feet 416 Linear Feet 104'

No Lines ONE Trench Width 36" Max Trench Bottom Depth 36" +

☐ New System ☑ Repair ☐ Expansion System Type: I (II) III IV V VI

System Description:

Repair System Description: 25% REDUCTION, GRAVITY

Maintenance Agreement Required: ☐ Yes ☑ No

Gravel Depth N/A ☑ Gravity ☐ Pressure

☑ House/Mod. Home No. Bedrooms 3

☐ Mobile Home No. Persons

☐ Business No. Employees

☐ Other


Water Supply: ☐ Individual ☑ Public ☐ Community

☑ Slab ☐ Crawl Space ☐ Basement w/plumbing ☐ Basement wo/plumbing

Comments:/Conditions: INSTALL ONE NEW 3'X104' DRAINLINE USING 25% REDUCTION SYSTEM AS SHALLOW AS POSSIBLE, AS FLAGGED, USING EXISTING DISTRIBUTION BOX

Comments:/Conditions: NEW SANITARY TEE INSTALLED IN SEPTIC TANK

INITIAL SITE SKETCH

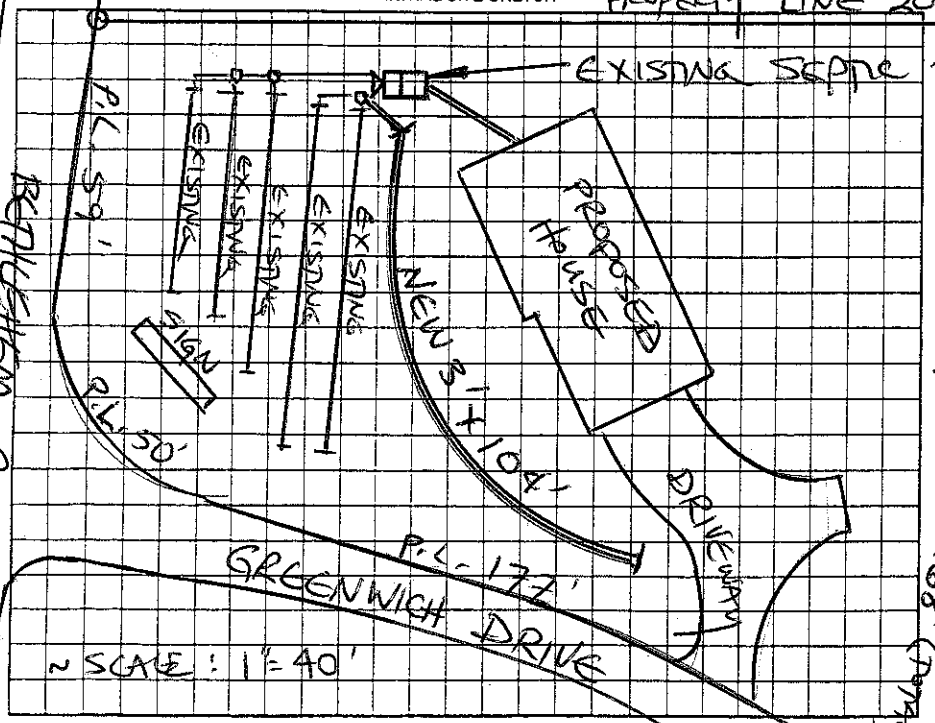

AS BUILT SKETCH

SYSTEM REPAIRED ACCORDING TO INITAL SITE SKETCH

Permit can be suspended or revoked if any false information is supplied toward securing the permit/any unauthorized changes are made to the site/any unauthorized changes are made in the installation of the system. Improvement Permit with plat valid without expiration ☐ Improvement Permit with site plan valid for sixty months ☑ Authorization to Construct is valid for a period equal to that of Improvement Permit – not to exceed sixty months.

Signed: C.M. Snouse date 1-30-07

Improvement Permit by: STEVE HENDRICK date 1-30-07

Authorization to Construct by: STEVE HENDRICK date 1-30-07

Installed by: PIEDMONT SEPTIC TANK (LINDS)

Operation Permit by: STEVE HENDRICK date 3-13-07

Existing System Inspection by: date

HEALTH DEPT. COPY: WHITE OWNER COPY (FINAL): YELLOW OWNER COPY (INITIAL): PINK