IREDELL COUNTY HEALTH DEPARTMENT

pd. # 300.00 UP

STATESVILLE 704-878-5305 MOORESVILLE 704-664-5281

IMPROVEMENT PERMIT / AUTHORIZATION TO CONSTRUCT / OPERATION PERMIT / EXISTING SYSTEM INSPECTION

PERMIT# — PIN# 4713878914 DATE 12/15/00

OWNER OR CONTRACTOR PRESTIGE BUILDERS / RICK HALSHMAN PHONE: Business 528-3999 Home

ADDRESS

LOCATION I 40 W- STAMEY FARM- TL STAMEY FARM - TO BETHLEHEM RD- ON LT CORNER OF

SUBDIVISION LANDINGS BLOCK / SECTION LOT 5 LOT AREA SITE CLASS. RS DESIGN FLOW 360 GPD L.T.A.R. .3000/FT²

Septic Tank: EXISTING 1000 Gallons; STB Date

Pump Tank: Gallons; PT Date

Pump Make: Model Serial No.

Nitrification Field: No Fields 1 Square Feet 900 Linear Feet 300

No Lines ADD 1 LINE Trench Width 36" Max Trench Bottom Depth 36" ~~Gravel~~ Depth SAND

☐ New System ☐ Repair System Type: I, II, (III), IV, V, VI

System Description: GRAVITY INNOVATIVE/CHAMBER

Repair System Description: DUMP INNOVATIVE

Maintenance Agreement Required: ☐ Yes ☐ No

☒ ~~House~~/Mod. Home No. Bedrooms 3

☐ Mobile Home No. Bathrooms 3

☐ Business No. Employees

☐ Other


☐ Slab ☐ Crawl Space ☐ Basement w/plumbing ☐ Basement wo/plumbing

Water Supply: ☐ Individual ☒ Public ☐ Community


Comments:/Conditions:

Comments:/Conditions: 1) REMOVE ~~[illegible]~~ CHAMBERS FROM LINE NUMBER (3) UNTIL LINE IS 60 FEET LONG. 2) REMOVE ~~[illegible]~~ ONLY ONE CHAMBER ON LINE (4) WHERE LINE IS 48 FEET LONG.

INITIAL SITE SKETCH

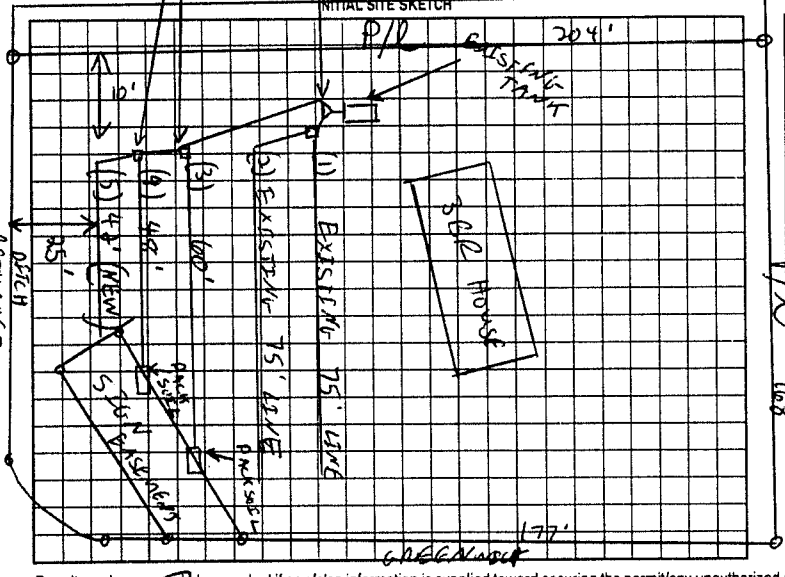

AS BUILT SKETCH

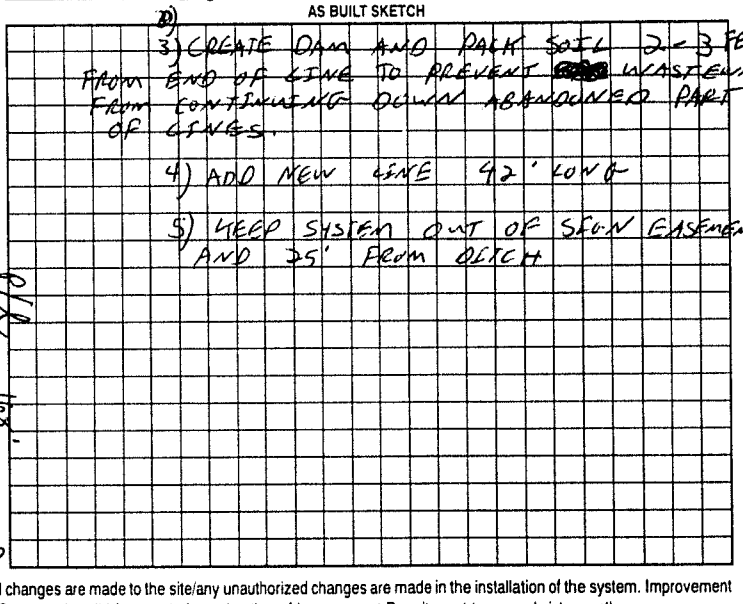

Permit can be suspended or revoked if any false information is supplied toward securing the permit/any unauthorized changes are made to the site/any unauthorized changes are made in the installation of the system. Improvement Permit with plat valid without expiration. Improvement Permit with site plan valid for sixty months. Authorization to Construct is valid for a period equal to that of Improvement Permit – not to exceed sixty months.

Signed: Rick Halshman date 12-18-00 Installed by: KURT DUNNING

Improvement Permit by: C. [illegible] RS date 12/15/00 Operation Permit by: C. [illegible] RS date 1/5/01

Authorization to Construct by: C. [illegible] RS date 12/15/00 Existing System Inspection by: date

HEALTH DEPT. COPY: WHITE OWNER COPY (FINAL): YELLOW OWNER COPY (INITIAL): PINK