PP 9/25 12-8-97

IREDELL COUNTY HEALTH DEPARTMENT

STATESVILLE 704-878-5305 MOORESVILLE 704-664-5281

IMPROVEMENT PERMIT / CERTIFICATE OF COMPLETION / OPERATION PERMIT / EXISTING SYSTEM INSPECTION

PROPERTY DESCRIPTION NO. 70462 DATE 12-4-97 TAX MAP NO. 4713966792 Watershed: ☐ Yes ☐ No

OWNER OR CONTRACTOR D.E. Earnhardt PHONE: Business 704 924 7120 Home

ADDRESS PO Box 5806 Statesville

LOCATION 70 W TL Bethlehem Past Airport Runway on left

SUBDIVISION The Landings BLOCK / SECTION LOT 5 LOT AREA .56 SITE CLASS 5 PS DESIGN FLOW 360 L.T.A.R. .13

Septic Tank: 1000 Gallons; STB 1612 Date 2-4-98

Pump Tank: Gallons; PT Date

Pump Make: Model Serial No.

Nitrification Field: No Fields 1 Square Feet 900 Linear Feet 300

No Lines 3 Trench Width 36" Max Trench Bottom Depth 36" Gravel Depth N/A

☑ New System ☐ Repair System Type: I, II, III, IV, V, VI

System Description: Gravity Chambers

Repair System Description: Pump to chambers

Maintenance Agreement Required: ☐ Yes ☐ No

☐ Slab ☑ Crawl Space ☐ Basement w/plumbing ☐ Basement wo/plumbing

☑ House/Mod. Home No. Bedrooms 3

☐ Mobile Home No. Bathrooms 2

☐ Business No. Employees

☐ Other


Water Supply: ☐ Individual ☐ Community ☑ Public

Comments:


Comments:

* 4 lines @ 75

INITIAL SITE SKETCH

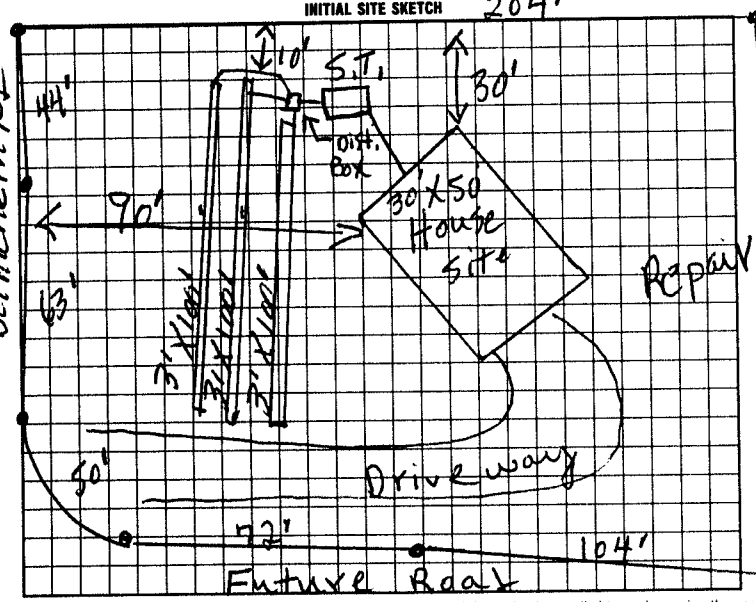

AS BUILT SKETCH

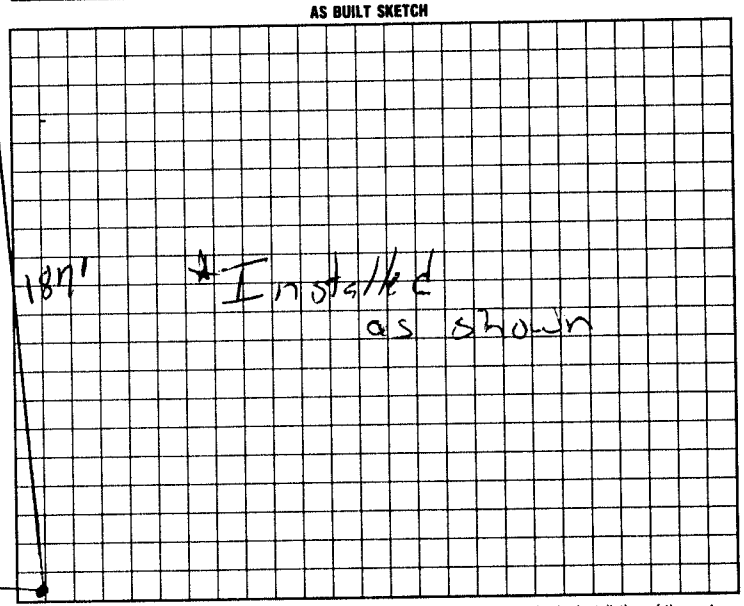

I understand that this permit can be suspended or revoked if any false information is supplied toward securing the permit/any unauthorized changes are made to the site/any unauthorized changes are made in the installation of the system. Improvement Permit is valid for 60 months from date of issuance.

Signed: [signature] for Lee Earnhardt

Improvement Permit by: L. C. moore date 12-4-97

Authorization / Existing System Inspection by: L. C. moore date 12-4-97

Installed by: A-1 Backhoe

Certificate of Completion by: date

Operation Permit by: M of C Off date 4-7-98

HEALTH DEPT. COPY: WHITE INSPECTION COPY (FINAL): GREEN OWNER COPY (FINAL): YELLOW INSPECTION COPY (INITIAL): PINK OWNER COPY (INITIAL): GOLD

$ to count. Authorization to count EXPIRES 60 mos from issue