IREDELL COUNTY HEALTH DEPARTMENT

STATESVILLE 704-878-5305 (2) MOORESVILLE 704-664-5281

IMPROVEMENT PERMIT / AUTHORIZATION TO CONSTRUCT / OPERATION PERMIT / EXISTING SYSTEM INSPECTION

PERMIT# 102475 PIN# 4713-86-6792.53 DATE 9-28-01

OWNER OR CONTRACTOR DEWEY SAUNDERS PHONE: Business (704) 892-1160 Home

ADDRESS 17720-A KINGS POINT DR, CORNELIUS NC 28031

LOCATION US 70 W, TL BETHLEHEM RD, TL GREENWICH DR, TL HEATHROW LANE 3RD LOT ON RIGHT

SUBDIVISION THE LANDINGS BLOCK / SECTION III LOT 53 LOT AREA 0.43 ACRES SITE CLASS PS DESIGN FLOW 360 L.T.A.R. 0.30 GPD/FT²

Septic Tank: 1000 Gallons: STB 1007 Date 1-20-02
Pump Tank: _____ Gallons: PT _____ Date _____
Pump Make: _____ Model _____ Serial No. _____
Nitrification Field: No Fields 1 Square Feet 1200 Linear Feet 400
No Lines FOUR Trench Width 36" Max Trench Bottom Depth 36"

☑ New System ☐ Repair System Type: I (II) III, IV, V, VI
System Description: CONVENTIONAL GRAVITY
Repair System Description: 50% REDUCTION (WILL PLACE)
Maintenance Agreement Required: ☐ Yes ☑ No

Gravel Depth 12"
☑ Slab ☒ Crawl Space ☐ Basement w/plumbing ☐ Basement wo/plumbing


☑ House/Mod. Home No. Bedrooms 3
☐ Mobile Home No. Bathrooms 2
☐ Business No. Employees _____
☐ Other _____

Water Supply: ☐ Individual ☒ Public ☐ Community


Comments/Conditions: KEEP STUB-OUT FROM UNDER SLAB SHALLOW TO ACCOMMODATE MAXIMUM TRENCH DEEP OF 36" OR LESS (2) SCOUR TRENCH SIDEWALLS & APPLY LIME PRIOR TO STONE.

Comments/Conditions: SEPTIC TANK WITH MARKER INSTALLED USING "POLYLOK" FILTER

INITIAL SITE SKETCH

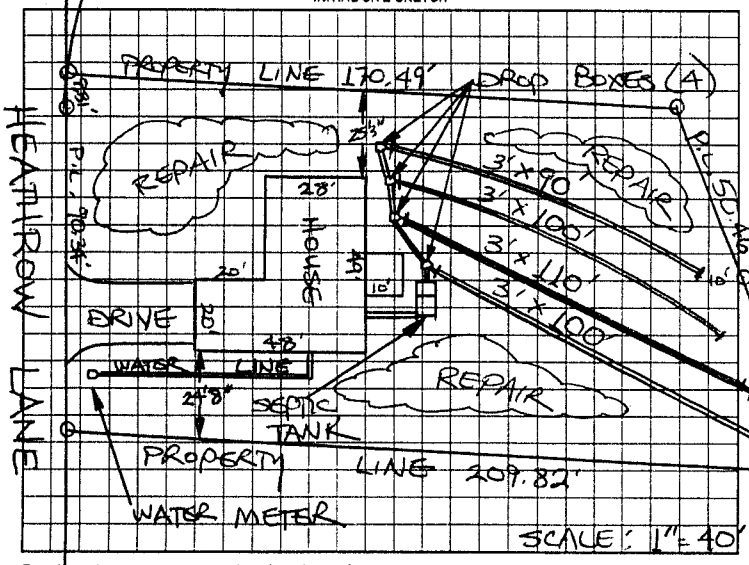

AS BUILT SKETCH

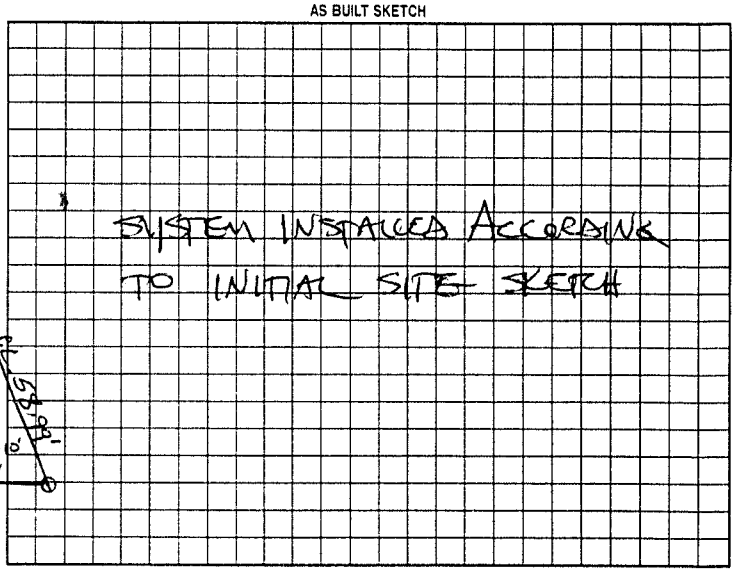

Permit can be suspended or revoked if any false information is supplied toward securing the permit/any unauthorized changes are made to the site/any unauthorized changes are made in the installation of the system. Improvement Permit with plat valid without expiration. Improvement Permit with site plan valid for sixty months. Authorization to Construct is valid for a period equal to that of Improvement Permit – not to exceed sixty months.

Signed: _____ date 10/3/01 Installed by: STATESVILLE BACKHOE

Improvement Permit by: STEVE HEDRICK date 9-28-01 Operation Permit by: STEVE HEDRICK date 3-1-02

Authorization to Construct by: STEVE HEDRICK date 9-28-01 Existing System Inspection by: _____ date _____

HEALTH DEPT COPY: WHITE OWNER COPY (FINAL): YELLOW OWNER COPY (INITIAL): PINK