CI

IREDELL COUNTY HEALTH DEPARTMENT

STATESVILLE 704-878-5305 MOORESVILLE 704-664-5281

IMPROVEMENT PERMIT / AUTHORIZATION TO CONSTRUCT / OPERATION PERMIT / EXISTING SYSTEM INSPECTION

PERMIT# 105293 PIN# 4713-86-4177 DATE 03-27-02

OWNER OR CONTRACTOR RICK TALENT PHONE: Business 704-902-4040 Home

ADDRESS 166 BRANDYWINE LOOP STATESVILLE NC 28677

LOCATION OMR, (L) BETHLEHAM (R) LANDINGS, (L) HEATHROW, AT END IN CUL-DE-SAC

SUBDIVISION LANDINGS BLOCK / SECTION 4 LOT LOT AREA 10 AC SITE CLASS PS DESIGN FLOW 360 L.T.A.R. .3

Septic Tank: 1000 Gallons; STB 312 Date 10-16-01
Pump Tank: Gallons; PT Date
Pump Make: Model Serial No
Nitrification Field: No Fields 1 Square Feet 1200 Linear Feet 400'
No Lines 3x133' Trench Width 36" Max Trench Bottom Depth 36 Gravel Depth 12"

X New System ☐ Repair System Type: I (II) III IV V VI
System Description: CONV 6RA-1
Repair System Description: SAME
Maintenance Agreement Required: ☐ Yes X No
☐ Slab X Crawl Space ☐ Basement w/plumbing ☐ Basement wo/plumbing


X House/Mod. Home No. Bedrooms 3
☐ Mobile Home No. Bathrooms 3
☐ Business No. Employees
☐ Other

Water Supply: ☐ Individual X Public ☐ Community


Comments/Conditions: (1) MAINTAIN SETBACKS (2) INSTALL LINES ON CONTOURS (3) CALL PRIOR TO INSTALLATION FOR FLAGOUT.

Comments/Conditions: 2ABCL FILTER & MARKER
V'D LAST 2 LINES.
HOUSE NOT FINISHED AT TIME OF CHECK.
V'D 3120 CMC-OK 07-31-02 LC

INITIAL SITE SKETCH "NOT TO SCALE"

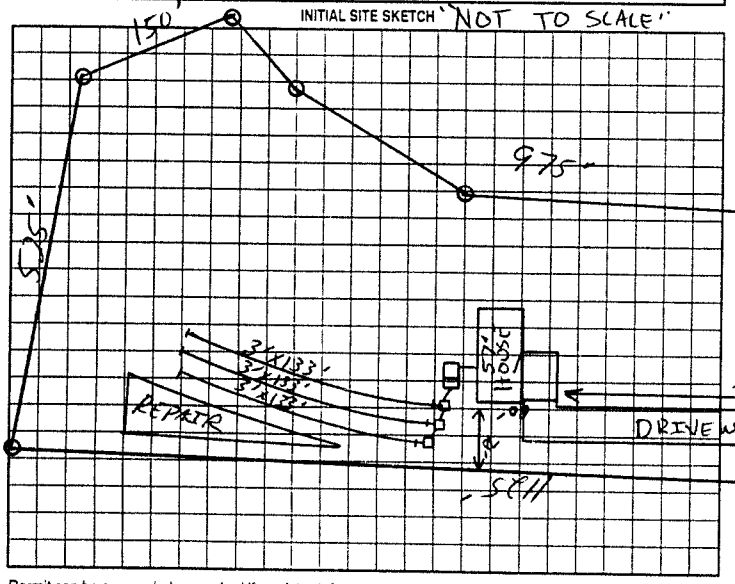

AS BUILT SKETCH

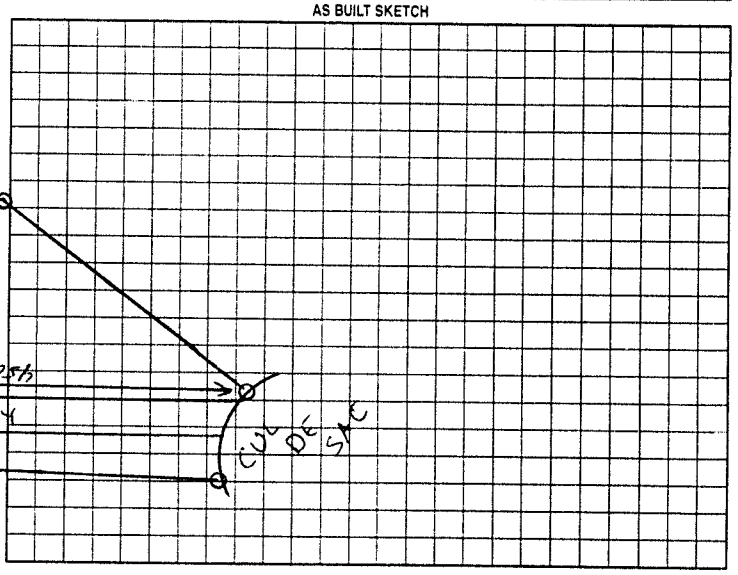

Permit can be suspended or revoked if any false information is supplied toward securing the permit/any unauthorized changes are made to the site/any unauthorized changes are made in the installation of the system. Improvement Permit with plat valid without expiration. Improvement Permit with site plan valid for sixty months. Authorization to Construct is valid for a period equal to that of Improvement Permit - not to exceed sixty months.

Signed: date 3/27/02 Installed by: STATESVILLE BACKHOE

Improvement Permit by: date 03-26-02 Operation Permit by: date 07-31-02

Authorization to Construct by: date 03-26-02 Existing System Inspection by: date

HEALTH DEPT. COPY WHITE OWNER COPY (FINAL) YELLOW OWNER COPY (INITIAL) PINK