pd125 12-8-97

IREDELL COUNTY HEALTH DEPARTMENT

STATESVILLE 704-878-5305 MOORESVILLE 704-664-5281

IMPROVEMENT PERMIT / CERTIFICATE OF COMPLETION / OPERATION PERMIT / EXISTING SYSTEM INSPECTION

PROPERTY DESCRIPTION NO. 70461 DATE 12-4-97 TAX MAP NO. 4913 866792 P.T. Watershed: ☐ Yes ☐ No

OWNER OR CONTRACTOR D.E. Earnhardt PHONE: Business 704924 7120 Home

ADDRESS PO Box 5806 Statesville N.C.

LOCATION 70W Tl. Bethlehem Rd Past Airport Runway Property on left

SUBDIVISION The Lantings BLOCK / SECTION LOT 3 LOT AREA .51 acres SITE CLASS P5 DESIGN FLOW 360 L.T.A.R. .3

Septic Tank: 1000 Gallons; STB 1012 Date 2-4-98
Pump Tank: Gallons; PT Date
Pump Make: Model Serial No.
Nitrification Field: No Fields 1 Square Feet 900 Linear Feet 300
No Lines 3 Trench Width 36" Max Trench Bottom Depth 36" Gravel Depth N/A

☑ New System ☐ Repair System Type: I, II, III, IV, V, VI
System Description: Gravity Chambers
Repair System Description: LPP
Maintenance Agreement Required: ☐ Yes ☑ No


☑ House/Mod. Home No. Bedrooms 3
☐ Mobile Home No. Bathrooms 1
☐ Business No. Employees
☐ Other
☐ Slab ☑ Crawl Space ☐ Basement w/plumbing ☐ Basement wo/plumbing

Water Supply: ☐ Individual ☐ Community ☑ Public


Comments:

Comments:
4 Lines @ 75ft

INITIAL SITE SKETCH

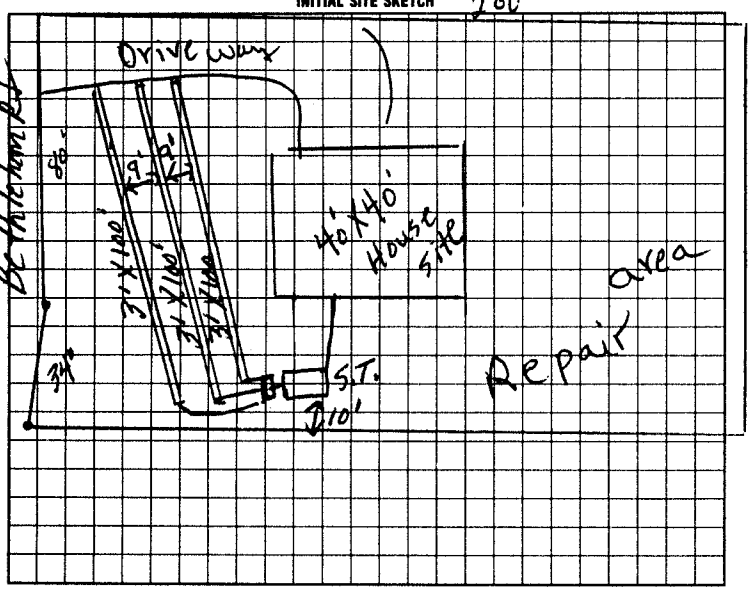

AS BUILT SKETCH

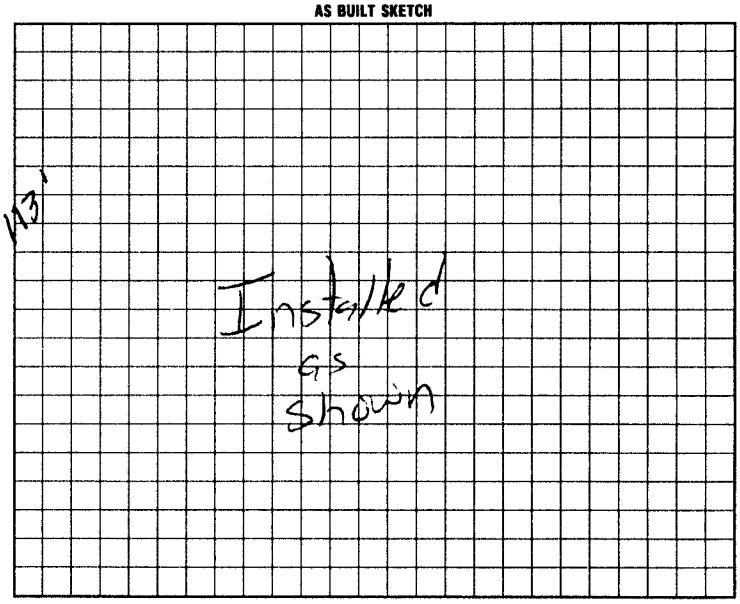

I understand that this permit can be suspended or revoked if any false information is supplied toward securing the permit/any unauthorized changes are made to the site/any unauthorized changes are made in the installation of the system. Improvement Permit is valid for 60 months from date of issuance.

Signed: [signature] for Lee Earnhardt

Improvement Permit by: R.C. moore date 12-4-97

Authorization to Construct/Existing System Inspection by: R.C. moore date 12-4-97

Installed by: A-1 Backhoe

Certificate of Completion by: date

Operation Permit by: [signature] date 4-7-98

HEALTH DEPT COPY: WHITE INSPECTION COPY (FINAL): GREEN OWNER COPY (FINAL): YELLOW INSPECTION COPY (INITIAL): PINK OWNER COPY (INITIAL): GOLD

to Const Authorization to Const EXPIRES 60 mos from issue