# IREDELL COUNTY HEALTH DEPARTMENT

STATESVILLE 704-878-5305 MOORESVILLE 704-664-5281

## IMPROVEMENT PERMIT / AUTHORIZATION TO CONSTRUCT / OPERATION PERMIT / EXISTING SYSTEM INSPECTION

PERMIT# 110195 PIN# 4713-97-1479 DATE 01/02/03

OWNER OR CONTRACTOR COLLIER PROPERTIES, LLC PHONE: Business 704-201-4993 ~~Home~~ 704-924-7120 (Rob Collier) 704-892-1160

ADDRESS P.O. BOX 5806 STATESVILLE, NC 28687

LOCATION OLD MTN RD, (L) BETHLEHEM RD, (R) GREENWICH, (L) HEATHROW LN., LOT ON LEFT ON CURVE.

SUBDIVISION THE LANDINGS BLOCK / SECTION III LOT 81 LOT AREA (81) 0.37 ACRES OFFSITE AREA 0.47 ACRES SITE CLASS. PS DESIGN FLOW 360 GPD L.T.A.R. 0.30 OFFSITE / 0.25 ON-SITE

Septic Tank: 1,000 Gallons; STB 05/24/02 Date 1012
Pump Tank: 1,000 Gallons; PT @1117 Date 02/14/02
Pump Make: GOULDS Model 1PWE05111 Serial No. S04786 (½ HP)
Nitrification Field: No Fields 1 Square Feet EQ to 1,200 Linear Feet 300
No Lines 5@60' Trench Width 36" Max Trench Bottom Depth 36" Gravel Depth N/A

[X] New System [ ] Repair System Type: I, II, (III), IV, V, VI
System Description: PUMP OFFSITE, 25% Reduction
Repair System Description: LOW PRESSURE, 50% Reduc.
Maintenance Agreement Required: [ ] Yes [X] No

[X] House/Mod. Home No. Bedrooms 3
[ ] Mobile Home No. Bathrooms 2½
[ ] Business No. Employees
[ ] Other
[ ] Slab [X] Crawl Space [ ] Basement w/plumbing [ ] Basement wo/plumbing


Water Supply: [ ] Individual [X] Public [ ] Community


Comments/Conditions: (1) SEE ATTACHED SHEETS FOR PUMP & PRESSURE MANIFOLD INFO, [redacted]

Comments/Conditions: (2) SEE ATTACHED EASEMENT PAPERS.

*SEPTIC TANK INSTALLED USING TUFF-TIGHT FILTER & MARKER.
*SYSTEM INSTALLED DURING PERIOD OF WET SOIL CONDITIONS,


INITIAL SITE SKETCH

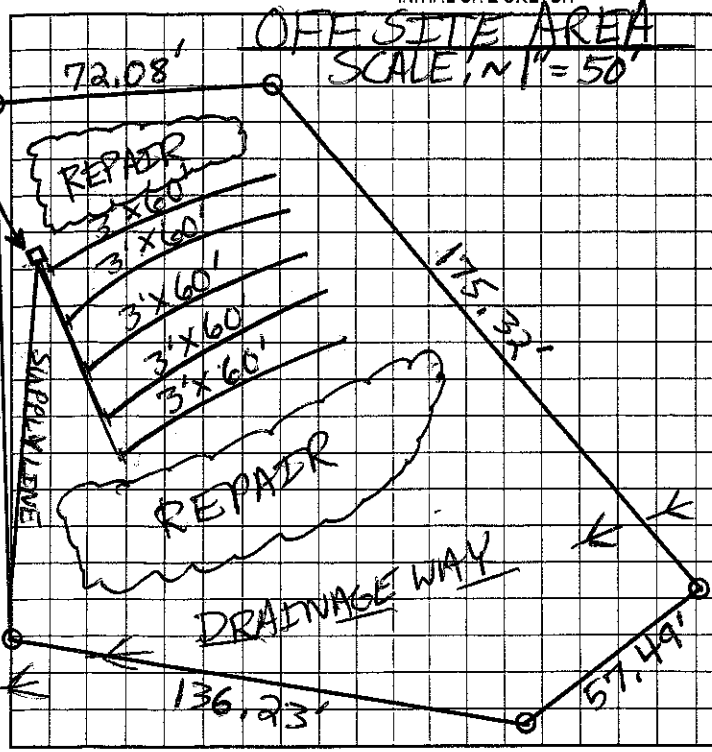

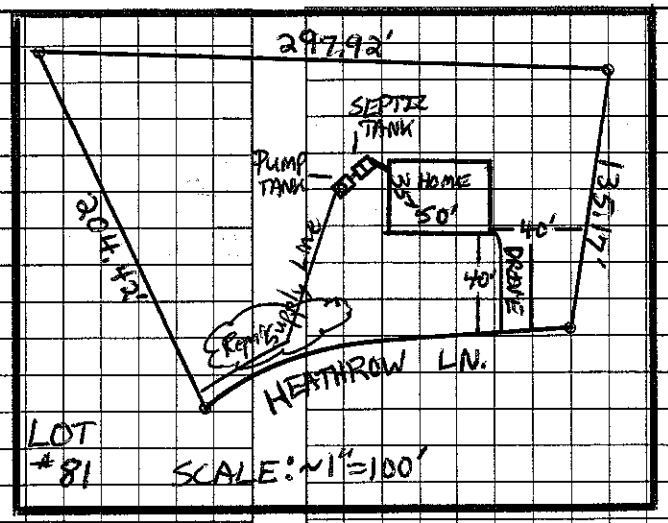
AS BUILT SKETCH

*SYSTEM INSTALLED AS SHOWN IN INITIAL SITE SKETCH
- ONLY CHANGE: TANK LOCATIONS SHOWN BELOW.

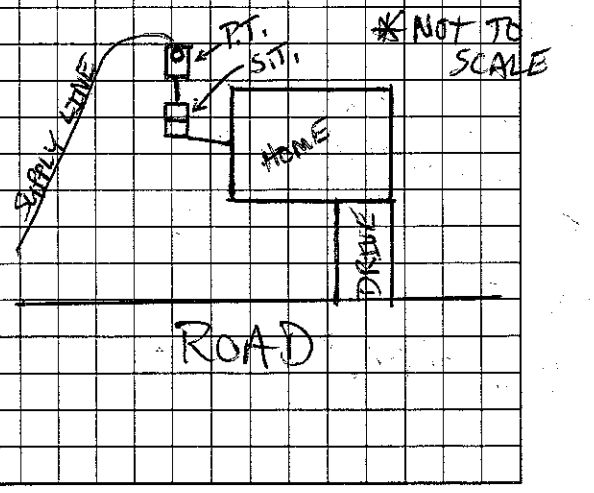


Permit can be suspended or revoked if any false information is supplied toward securing the permit/any unauthorized changes are made to the site/any unauthorized changes are made in the installation of the system. Improvement Permit with plat valid without expiration. Improvement Permit with site plan valid for sixty months. Authorization to Construct is valid for a period equal to that of Improvement Permit – not to exceed sixty months.

Signed: [signature] date 1-6-03 Installed by: A-1 BACKHOE 03-03-03

Improvement Permit by: Patrick Mitchell date 01/02/03 Operation Permit by: Patrick Mitchell date 03/31/03

Authorization to Construct by: Patrick Mitchell date 01/02/03 Existing System Inspection by: _____ date _____

HEALTH DEPT. COPY: WHITE OWNER COPY (FINAL): YELLOW OWNER COPY (INITIAL): PINK