IREDELL COUNTY HEALTH DEPARTMENT

STATESVILLE 704-878-5305 MOORESVILLE 704-664-5281

IMPROVEMENT PERMIT / AUTHORIZATION TO CONSTRUCT / OPERATION PERMIT / EXISTING SYSTEM INSPECTION

PERMIT# 107466 PIN# 4713-86-4177 DATE 08/28/02

OWNER OR CONTRACTOR COLLIER PROPERTIES PHONE: Business 704-924-7120 Home 704-201-4993

ADDRESS P.O. BOX 5806 STATESVILLE, NC 28687

LOCATION OLD MOUNTAIN RD, (TL) BETHLEHEM RD, (TR) GREENWICH DR, (TL) HEATHROW LN, AT END ON LEFT OF CUL-DE-SAC

SUBDIVISION THE LANDINGS BLOCK / SECTION 4 LOT 83 LOT AREA 0.72 ACRES SITE CLASS PS DESIGN FLOW 360 GPD L.T.A.R. 0.25

Septic Tank: 1,000 Gallons: STB 1012 Date 07/07/02
Pump Tank: 1,000 Gallons: PT 1017 Date 09/02/02
Pump Make: MYERS Model MW50-11P Serial No. 26053D101
Nitrification Field: No Fields 1 Square Feet EQ to 1,440 Linear Feet 240
No Lines 6 x 40' Trench Width 24" Max Trench Bottom Depth 36"

X New System ☐ Repair System Type: I II (III) IV V VI
System Description: 50% REDUCTION, PUMP
Repair System Description: 50% REDUCTION, LOW PRESSURE
Maintenance Agreement Required: ☐ Yes X No
Gravel Depth N/A X Slab ☐ Crawl Space Basement w/plumbing ☐ Basement wo/plumbing


X House/Mod Home No Bedrooms 3
☐ Mobile Home No. Bathrooms 2½
☐ Business No Employees ____
☐ Other ____

Water Supply: ☐ Individual X Public ☐ Community

Comments/Conditions: (1) INSTALL SYSTEM USING 54 PANELS TO EQUAL 240 FEET (2) INSTALL LINES ON CONTOUR (3) PLACE HOME IN PROPOSED LOCATION TO MAXIMIZE REPAIR AREA, IF HOME MOVES IT 213.26'

Comments/Conditions: WELL DESTROY REPAIR AREA, VOIDING THIS PERMIT! (4) CALL PRIOR TO INSTALLATION FOR PUMP INFO & IF REFLAGGING IS NECESSARY.

INITIAL SITE SKETCH

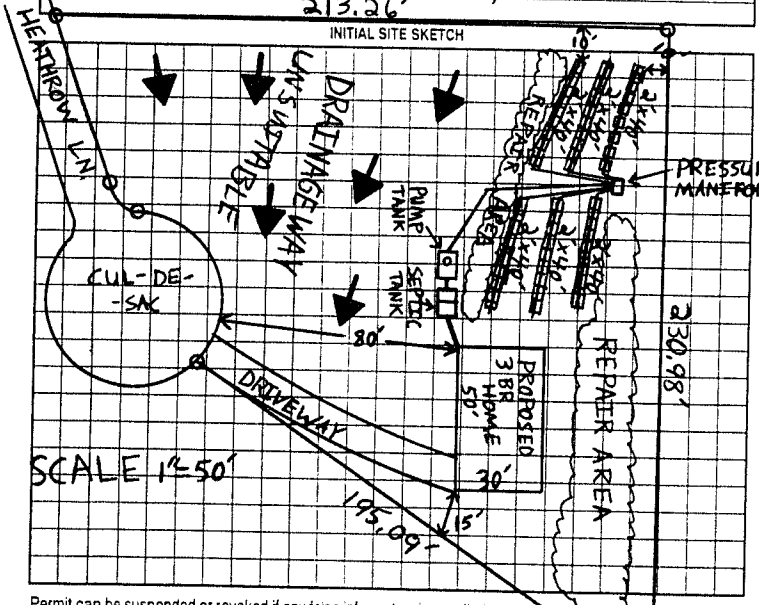

AS BUILT SKETCH

- SEPTIC TANK INSTALLED USING TUFF TIGHT FILTER & MARKER
* SYSTEM ~~INSTALLED DURING~~ WET SOIL CONDITIONS.
* SYSTEM INSTALLED AS SHOWN IN INITIAL SITE SKETCH.

Permit can be suspended or revoked if any false information is supplied toward securing the permit. Any unauthorized changes are made to the site any unauthorized changes are made in the installation of the system. Improvement Permit with plat valid without expiration. Improvement Permit with site plan valid for sixty months. Authorization to Construct is valid for a period equal to that of Improvement Permit – not to exceed sixty months

Signed: _____ 8-29-02 date _____ Installed by A-1 BACKHOE

Improvement Permit by: Patrick Mitchell date 08/28/02 Operation Permit by Patrick Mitchell date 12/17/02

Authorization to Construct by: Patrick Mitchell date 08/28/02 Existing System Inspection by: _____ date _____

HEALTH DEPT COPY WHITE OWNER COPY (FINAL) YELLOW OWNER COPY (INITIAL) PINK