IREDELL COUNTY HEALTH DEPARTMENT

Authorization to Const.

STATESVILLE 704-878-5305 MOORESVILLE 704-664-5281

IMPROVEMENT PERMIT / CERTIFICATE OF COMPLETION / OPERATION PERMIT / EXISTING SYSTEM INSPECTION

PROPERTY DESCRIPTION NO. 25670 DATE 12-19-96 TAX MAP NO. 8k-D-94 Watershed: ☐ Yes ☒ No

OWNER OR CONTRACTOR Phillip Segal's Jr. PHONE: Business Home 873-9788

ADDRESS 104 Bobby loop Statesville

LOCATION I40 TL Stanny Farm Straight Bethlehem Rd House straight at Bend

SUBDIVISION BLOCK / SECTION LOT 2 LOT AREA 0.754c SITE CLASS. PS DESIGN FLOW 240 L.T.A.R. 0.3

Septic Tank: 1000 Gallons; STB 794 Date 4-30-96

Pump Tank: Gallons; PT Date

Pump Make: Model Serial No.

Nitrification Field: No Fields 1 Square Feet 800 Linear Feet 266

No Lines 3 Trench Width 36 Max Trench Bottom Depth 36

☒ New System ☐ Repair System Type: I, II, III, IV, V, VI

System Description: Gravity Conventional

Repair System Description: Gravity Conven/Pump Conv.

Maintenance Agreement Required: ☐ Yes ☐ No

Gravel Depth 12

☐ House/Mod. Home ☒ Mobile Home ☐ Business ☐ Other

No. Bedrooms 2 No. Bathrooms 2 No. Employees


☐ Slab ☒ Crawl Space ☐ Basement w/plumbing ☐ Basement wo/plumbing

Water Supply: ☒ Individual ☐ Community ☐ Public


Comments: keep lines on contour 9ft on center
keep well 50ft from system

Comments:

INITIAL SITE SKETCH

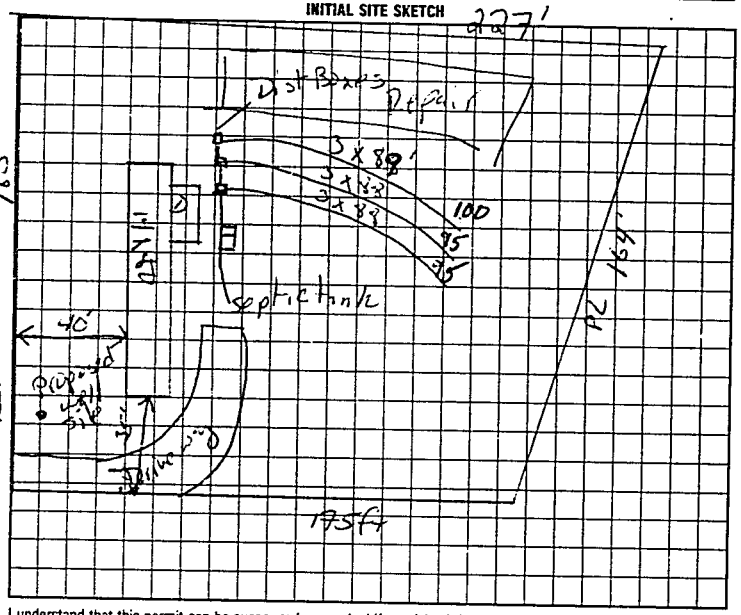

AS BUILT SKETCH

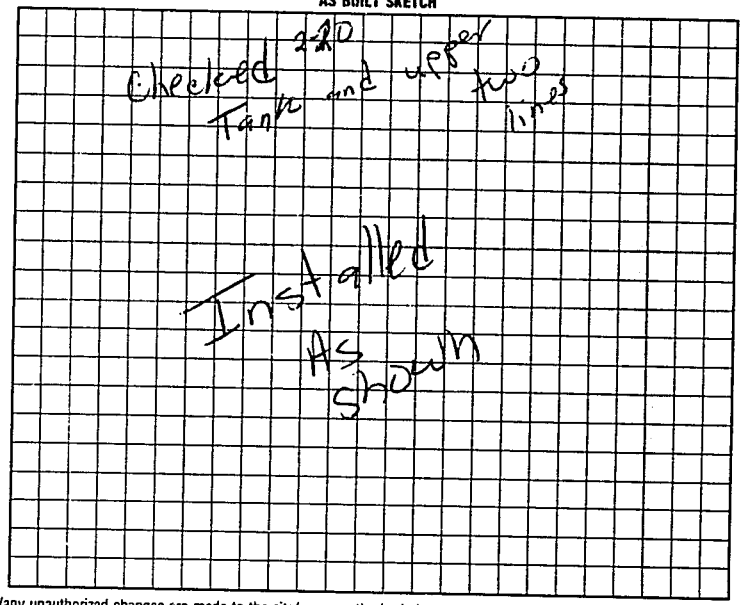

I understand that this permit can be suspended or revoked if any false information is supplied toward securing the permit/any unauthorized changes are made to the site/any unauthorized changes are made in the installation of the system.

Authorization to Const. expires 5yrs from issue date

Signed:

Improvement Permit by: Mary C Ott RS date 12-19-96

Existing System Inspection by: Authorization to Const. Mary C Ott RS date 12-19-96

Installed by: Wes Lytton

Certificate of Completion by: date

Operation Permit by: Mary C Ott RS date 2-21-97

HEALTH DEPT. COPY: WHITE INSPECTION COPY (FINAL): GREEN OWNER COPY (FINAL): YELLOW INSPECTION COPY (INITIAL): PINK OWNER COPY (INITIAL): GOLD