IREDELL COUNTY HEALTH DEPARTMENT

STATESVILLE 704-878-5305 MOORESVILLE 704-664-5281

IMPROVEMENT PERMIT / AUTHORIZATION TO CONSTRUCT / OPERATION PERMIT / EXISTING SYSTEM INSPECTION

PERMIT# 83103 PIN# 4714 80 7155 DATE 8-4-99

OWNER OR CONTRACTOR Adlington Racing PHONE: Business 606 928 1664 Home

ADDRESS 14350 Twin Ridge Ct. Ashland, KY

LOCATION Hwy 70 W To Bethlehem To Aviation Dr. 1/4 mi Left

SUBDIVISION BLOCK / SECTION LOT LOT AREA 5 acres SITE CLASS PS DESIGN FLOW 250 L.T.A.R. .13

Septic Tank: 1000 Gallons; STB 1012 Date 6-16-99
Pump Tank: Gallons; PT Date
Pump Make: Model Serial No.
Nitrification Field: No Fields 1 Square Feet 900 Linear Feet 300
No Lines 3 Trench Width 36" Max Trench Bottom Depth 36" Gravel Depth 12"

☑ New System ☐ Repair System Type: I II III IV V VI
System Description: Conv. Gravity
Repair System Description: Gravity 25% Reduct
Maintenance Agreement Required: ☐ Yes ☑ No

☐ House/Mod. Home No. Bedrooms
☐ Mobile Home No. Bathrooms
☑ Business No. Employees 10
☐ Other Racing Shop

☐ Slab ☐ Crawl Space ☐ Basement w/plumbing ☐ Basement wo/plumbing

Water Supply: ☐ Individual ☑ Public ☐ Community

Comments/Conditions:


523'

Comments/Conditions


Drop boxes

Installed as shown - Concrete risers.

INITIAL SITE SKETCH

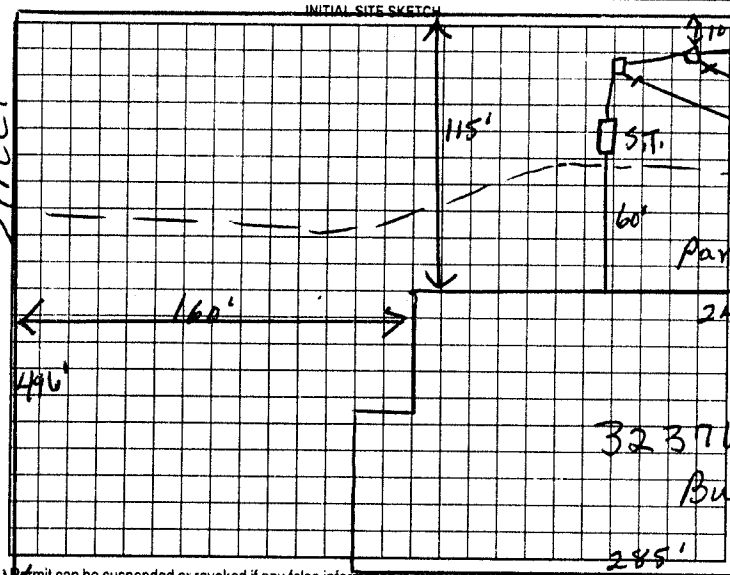

AS BUILT SKETCH

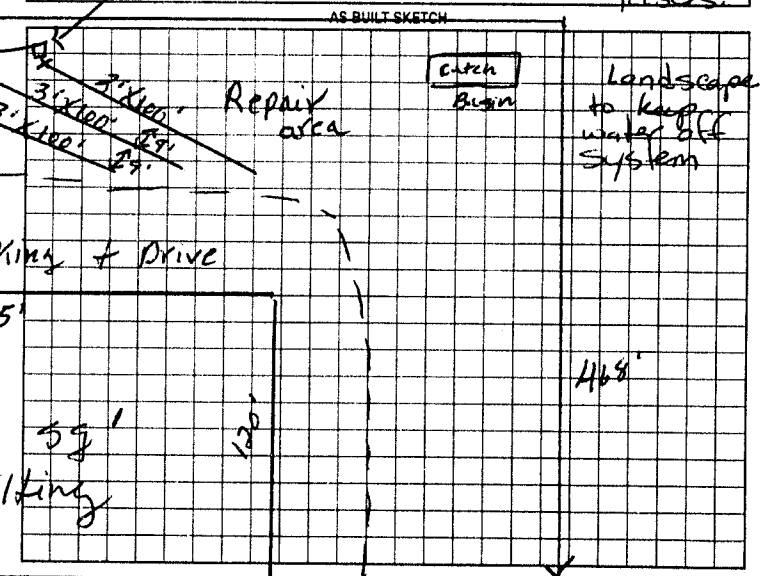

STREET

Permit can be suspended or revoked if any false information is supplied toward securing the permit, any unauthorized changes are made to the site, any unauthorized changes are made in the installation of the system. Improvement Permit with plat valid without expiration. Improvement Permit with site plan valid for sixty months. Authorization to Construct is valid for a period equal to that of Improvement Permit - not to exceed sixty months.

Signed: Allen Moore date 8-5-99 Installed by: Foothills Plumbing

Improvement Permit by: P. C. Moore date 8-4-99 Operation Permit by: Mat C. Off 28 date 8-27-99

Authorization to Construct by: P. C. Moore date 8-4-99 Existing System Inspection by: date

HEALTH DEPT COPY WHITE OWNER COPY (FINAL) YELLOW OWNER COPY (INITIAL) PINK