T. D.

IREDELL COUNTY HEALTH DEPARTMENT

Statesville Phone TR 3-7271 Mooresville Phone NO 3-1271

PERMIT TO INSTALL SEPTIC TANK

Permit NO. 364 Permit Date Oct 28 1969

Owner John W. Gibson Address Rt. 6 - Sta

Installed By W. L. Kodrick Address Rt 8 - Sta.


Location of Property Pondarosa acres Instate 40 + Old Fifth Road.

Tank		Capacity		Length of Lines		Fixtures	
Block	( )	1000	(✓)	225'	(✓)	No. of Baths	(2)
Precast	(✓)	1250	( )	250'	( )	Dishwasher	( )
		1500	( )	Other		Garbage Grdr.	( )
		Other				Other	

NOTIFY HEALTH DEPARTMENT AT LEAST EIGHT HOURS BEFORE TANK IS TO BE INSPECTED.

Final Inspection Oct 28 1969 Approved (✓) Disapproved ( )

Remarks

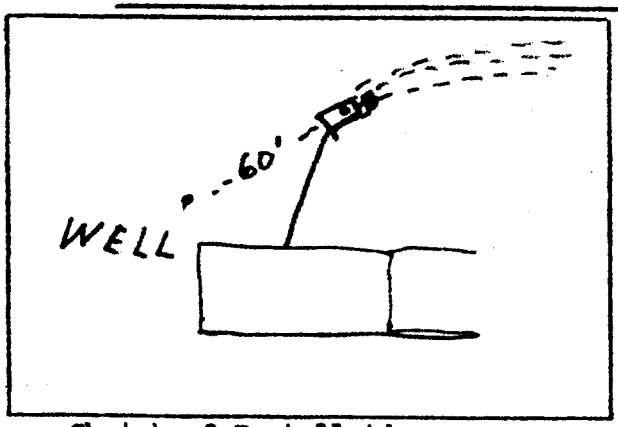

Sketch of Installation

Self. G.H.

Sanitarian