F. P.

IREDELL COUNTY HEALTH DEPARTMENT

tatesville Phone TR 3-7271 Mooresville Phone NO 3-1271

PERMIT TO INSTALL SEPTIC TANK

ermit NO. 314 Permit Date Oct 29 1969

wner Lester W. Wilson Address Rt. 6 - Box

nstalled By H.F. Rudisill Address Rt 2 - Box

ocation of Property Pendleton over Interstate


+ Old Nat. Rd.

Tank		Capacity		Length of Lines		Fixtures	
lock	( )	1000	( )	225'	(✓)	No. of Baths	(2)
recast	(✓)	1250	( )	250'	( )	Dishwasher	( )
		1500	( )	Other		Garbage Grdr.	( )
		Other				Other	

OTIFY HEALTH DEPARTMENT AT LEAST EIGHT HOURS BEFORE TANK IS TO BE INSPECTED

inal Inspection Oct 29 1969 Approved (✓) Disapproved ( )

emarks

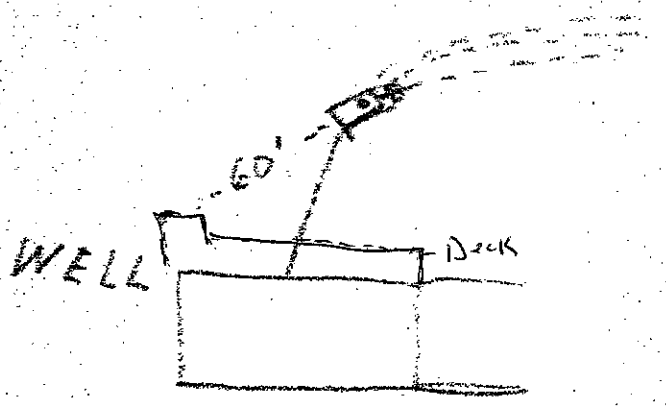

Sketch of Installation

The proposed Deck addition does not appear to impact the existing septic system.

**NOTE:

R.S.

Date: 17 Feb 09

ICHD-Environmental Health Division

Sanitarian

JAN. 1, 1989 4:16