IREDELL COUNTY HEALTH DEPARTMENT

STATESVILLE 704-878-5305 ✓ MOORESVILLE 704-664-5281

IMPROVEMENT PERMIT / AUTHORIZATION TO CONSTRUCT / OPERATION PERMIT / EXISTING SYSTEM INSPECTION

PERMIT# 083744 PIN# 4714 15 6472 DATE 11-8-00

OWNER OR CONTRACTOR JERRY LACKEY PHONE: Business Home (336) 885-7792

ADDRESS 4526 OAK HOLLOW ROAD, HIGH POINT, NC 27265

LOCATION ISLAND FORD ROAD, TL WATERMELON ROAD, ON LEFT IN CURVE BEFORE FISH POND,

SUBDIVISION BLOCK / SECTION LOT LOT AREA 1.89 ACRES SITE CLASS PS DESIGN FLOW 360 L.T.A.R. 0.15 GPD/FT²

Septic Tank: 1000 Gallons; STB 1072 Date 10-15-01
Pump Tank: 1000 Gallons; PT 17 Date 7-7-2000
Pump Make: Myers Model MWS6-III Serial No.
Nitrification Field: No Fields 1 Square Feet EQ TO 2400 Linear Feet 400
No Lines SIX Trench Width 24' Max Trench Bottom Depth 30'

✓ New System ☐ Repair System Type: I, II, III, IV, V, VI
System Description: LOW-PRESSURE PDBPS PANELS
Repair System Description: LOW-PRES PDBPS PANELS
Maintenance Agreement Required: ✓ Yes ☐ No
Gravel Depth SAND 6"


✓ House/Mod. Home No. Bedrooms 3
☐ Mobile Home No. Bathrooms 2½
☐ Business No. Employees
☐ Other
☐ Slab ✓ Crawl Space ☐ Basement w/plumbing ☐ Basement wo/plumbing

Water Supply: ✓ Individual ☐ Public ☐ Community
WELL


Comments/Conditions: ① INSTALL 50% REDUCTION SYSTEM USING 92 PDBPS PANELS USING LOW-PRESSURE DISTRIBUTION IN LINE LENGTHS AS SHOWN (17, 17, 16, 15, 14, & 13) ② INSTALL SUBSURFACE INTERCEPT DRAINAGE DITCH BEGINNING 48" DEEP TO DAYLIGHT

Comments/Conditions ③ SEE ATTACHED SHEETS FOR PUMP AND PRESSURE DISTRIBUTION REQUIREMENTS ④ A CONTRACT SHALL BE EXECUTED BETWEEN SYSTEM OWNER AND A MANAGEMENT ENTITY PRIOR TO ISSUANCE OF OPERATION PERMIT

INITIAL SITE SKETCH

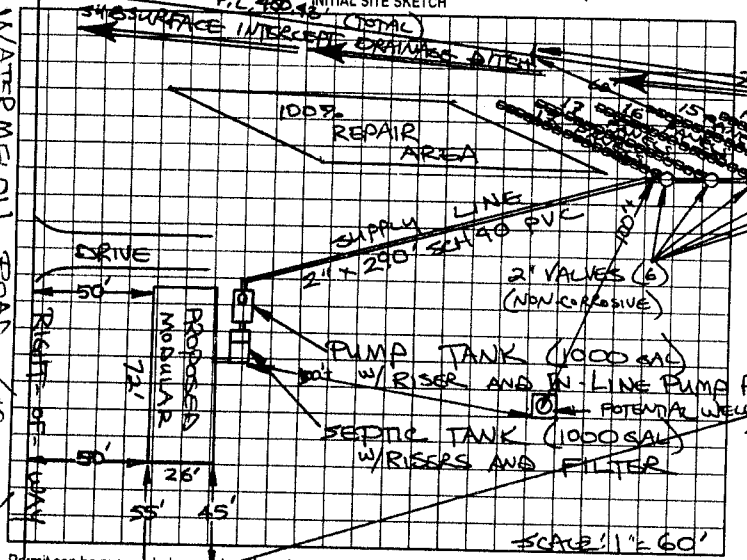

AS BUILT SKETCH

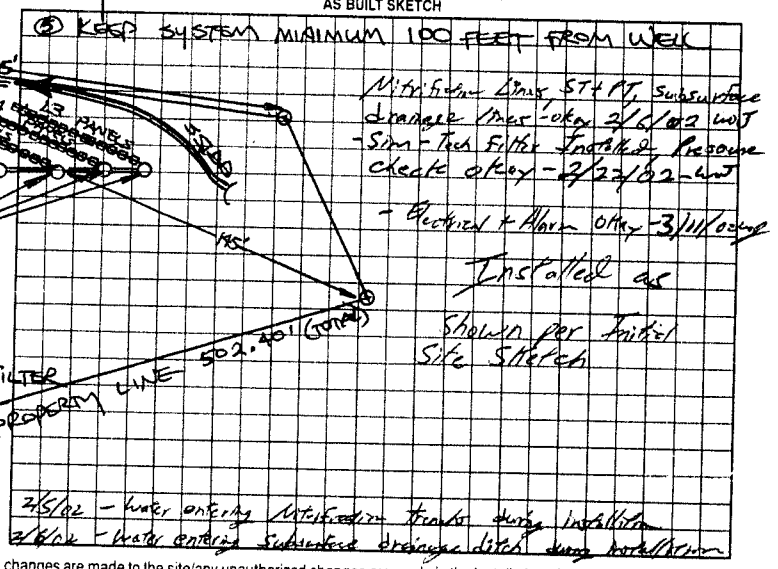

Permit can be suspended or revoked if any false information is supplied toward securing the permit/any unauthorized changes are made to the site/any unauthorized changes are made in the installation of the system. Improvement Permit with plat valid without expiration. Improvement Permit with site plan valid for sixty months. Authorization to Construct is valid for a period equal to that of Improvement Permit – not to exceed sixty months.

Signed Jerry B. Lackey date 11-20-00 Installed by: A-1 Back Hoe

Improvement Permit by: STEVE HEDRICK date 11-8-00 Operation Permit by: William O. Johnson date 3/12/02

Authorization to Construct by: STEVE HEDRICK date 11-8-00 Existing System Inspection by: date

HEALTH DEPT. COPY: WHITE OWNER COPY (FINAL): YELLOW OWNER COPY (INITIAL): PINK