IREDELL COUNTY HEALTH DEPARTMENT

STATESVILLE 704-878-5305 MOORESVILLE 704-664-5281

IMPROVEMENT PERMIT / AUTHORIZATION TO CONSTRUCT / OPERATION PERMIT / EXISTING SYSTEM INSPECTION

PERMIT# 46662 / 18212 PIN# 4714-35-6143 DATE 1/29/04

OWNER OR CONTRACTOR Carolina Tractor & Equipment Co PHONE: Business 828-312-0673 Home –

ADDRESS 900 Statesville Rd Charlotte, N.C. 28269

LOCATION I-40 W, (R) on Stamey Farm Rd., (L) on Watermelon on Left

SUBDIVISION – BLOCK / SECTION – LOT – LOT AREA 6.29 Acres SITE CLASS. P5 DESIGN FLOW 500 L.T.A.R. .25

Septic Tank: 4,000 Gallons; STB 1012 Date 10-4-03

Pump Tank: 1,500 Gallons; PT 99 Date 11-10-03

Pump Make: Gaulds Model WE10124 Serial No. M0342923

Nitrification Field: No Fields 1 Square Feet 2,000 Linear Feet 360

No Lines 7 Trench Width 2Ft Max Trench Bottom Depth 36" Gravel Depth 6" (Rock)

☒ New System ☐ Repair System Type: I, II, III, (IV), V, VI

System Description: Pump, Low Pressure Panel

Repair System Description: Pump, Low Pressure Panel

Maintenance Agreement Required: ☒ Yes ☐ No

☐ House/Mod. Home ☐ Mobile Home ☒ Business ☐ Other

No. Bedrooms ____ No. Bathrooms ____ No. Employees 20


☒ Slab ☐ Crawl Space ☐ Basement w/plumbing ☐ Basement wo/plumbing

Water Supply: ☒ Individual ☒ Public ☐ Community


Comments:/Conditions: (1) Install LP Panel system according to manufacturers (78 Panels) specifications (2) Install lines on contour (3) Attachments "A", "B" & "C" are part of this permit (3) Install French drain 48" to daylight (4) Mgmt Agreement must be executed before OP is issued. (5) maintain proper setbacks

Comments:/Conditions: - prior HP Approval to move 3" Supply line to opposite side of property. - Pressure check, Set Float tree 4/23/04 mark / Sim-Tech Filter 4/16/04 - Tuff Tite Filter & ST marker installed. Lines Installed - Okay - French Drain Installed - Okay

INITIAL SITE SKETCH (1" = 100')

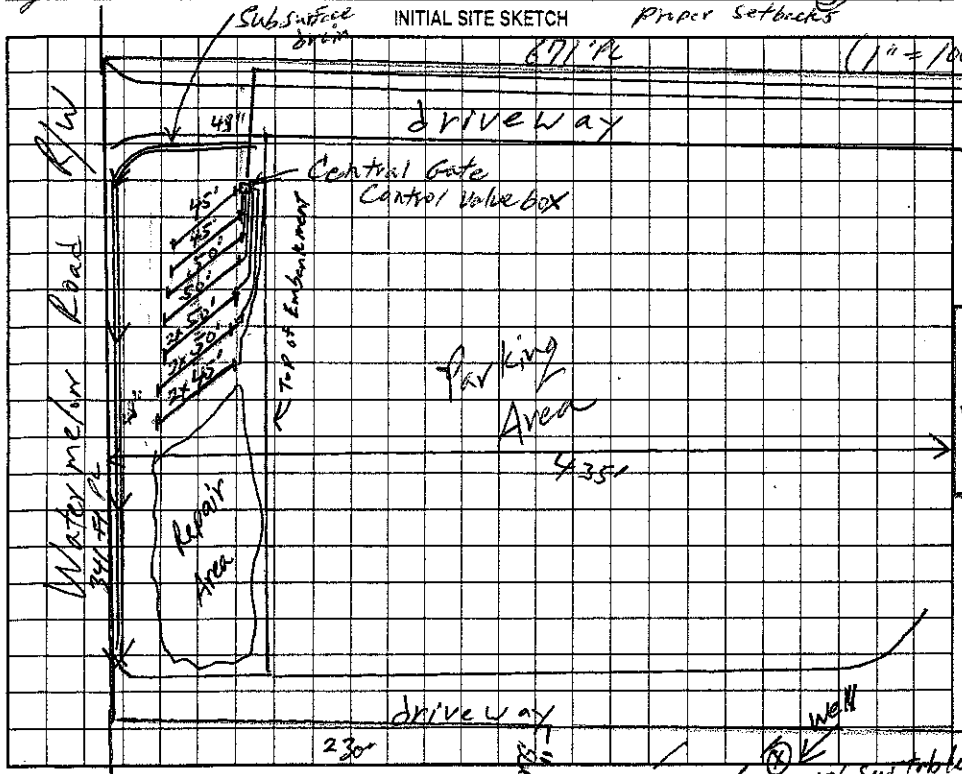

AS BUILT SKETCH

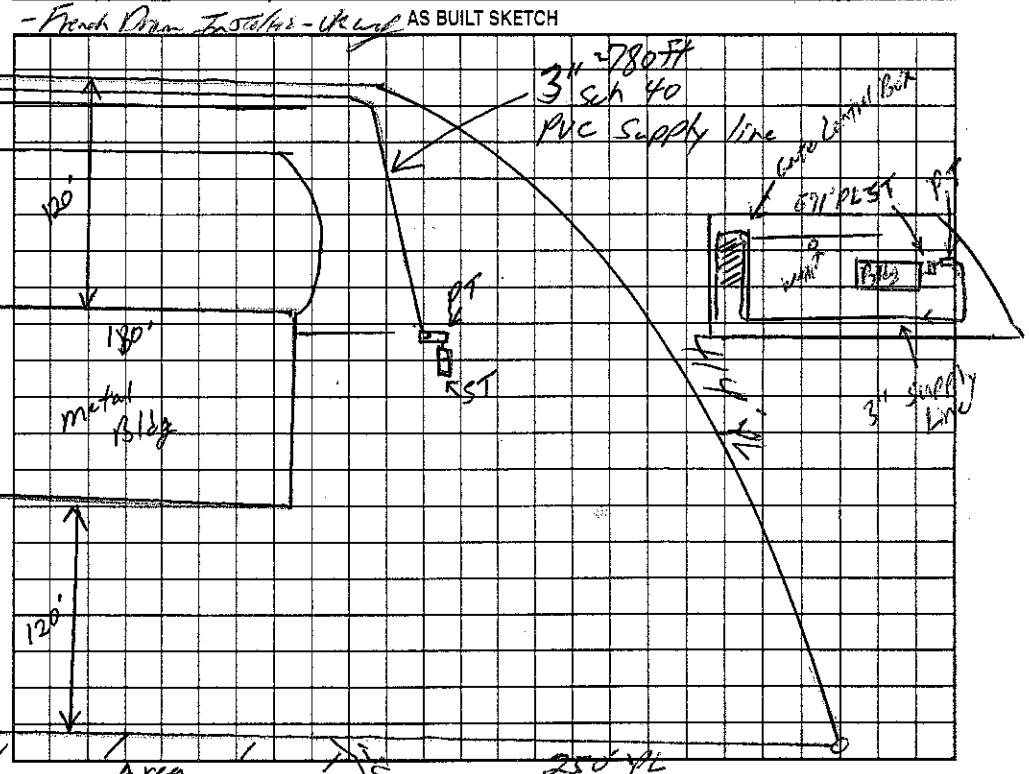

Permit can be suspended or revoked if any false information is supplied toward securing the permit/any unauthorized changes are made to the site/any unauthorized changes are made in the installation of the system. Improvement Permit with plat valid without expiration. Improvement Permit with site plan valid for sixty months. Authorization to Construct is valid for a period equal to that of Improvement Permit – not to exceed sixty months.

Signed: [signature] date 1/29/04 Installed by: William O. Johnson 5/24/04

Improvement Permit by: William O. Johnson date 1/29/04 Operation Permit by: A-1 Backhoe Service date ____

Authorization to Construct by: William O. Johnson date 1/29/04 Existing System Inspection by: ____ date ____

HEALTH DEPT. COPY: WHITE OWNER COPY (FINAL): YELLOW OWNER COPY (INITIAL): PINK