IREDELL COUNTY HEALTH DEPARTMENT

Voids Permit dated 6-20-96

STATESVILLE 704-878-5305 MOORESVILLE 704-664-5281

IMPROVEMENT PERMIT / CERTIFICATE OF COMPLETION / OPERATION PERMIT / EXISTING SYSTEM INSPECTION

PROPERTY DESCRIPTION NO. ~~2 9777 06 2297~~ DATE 5-2-97 TAX MAP NO. 8K-A-4 Watershed: ☐ Yes ☑ No

OWNER OR CONTRACTOR Edward Huffman PHONE: Business _____ Home 324-7635

ADDRESS 51 22nd Ave NW. Hickory, N.C. 28601

LOCATION Hwy 70 W TR Stamey Farm Rd 1st lot on left.

SUBDIVISION _____ BLOCK / SECTION _____ LOT 7 LOT AREA 43 acres± SITE CLASS. PS DESIGN FLOW 360 L.T.A.R. .3

Septic Tank: 1000 Gallons; STB ~~1000~~ 994 Date 2-27-97

Pump Tank: _____ Gallons; PT _____ Date _____

Pump Make: _____ Model _____ Serial No. _____

Nitrification Field: No Fields 1 Square Feet 1200 Linear Feet 400

No Lines 4 Trench Width 36" Max Trench Bottom Depth 36" Gravel Depth 12"

☐ New System ☐ Repair System Type: I, II, III, IV, V, VI

System Description: Conv. Gravity

Repair System Description: " "

Maintenance Agreement Required: ☐ Yes ☑ No

☑ House/Mod. Home No. Bedrooms 3

☐ Mobile Home No. Bathrooms 3

☐ Business No. Employees _____

☐ Other _____


☐ Slab ☐ Crawl Space ☑ Basement w/plumbing ☐ Basement wo/plumbing

Water Supply: ☐ Individual ☐ Community ☑ Public

Comments:

Drop boxes 3' x 100' 3' x 100' 3' x 100' 3' x 100'


INITIAL SITE SKETCH

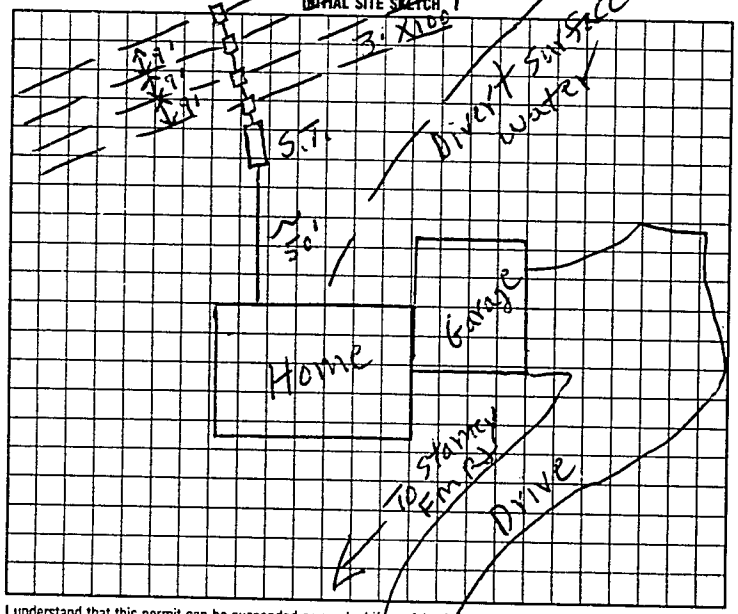

Comments:

Replaces Permit Issued 6-20-96

AS BUILT SKETCH

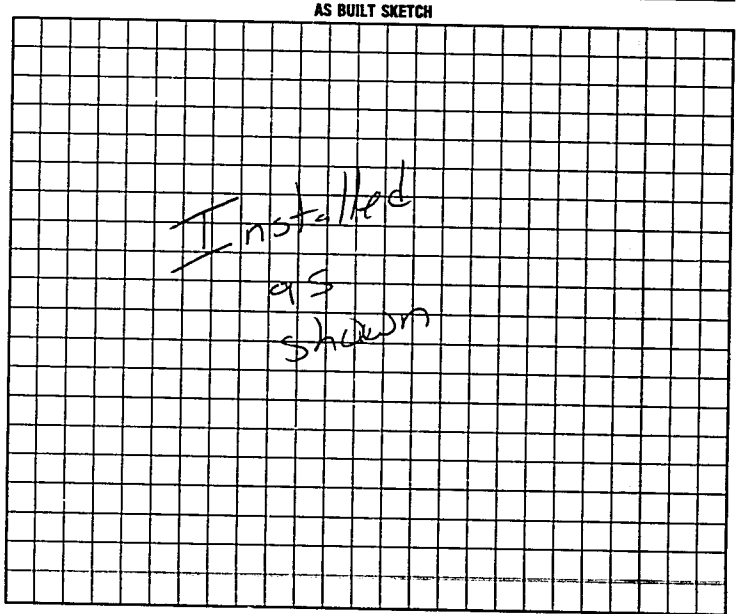

I understand that this permit can be suspended or revoked if any false information is supplied toward securing the permit/any unauthorized changes are made to the site/any unauthorized changes are made in the installation of the system. Improvement Permit is valid for 60 months from date of issuance.

Signed: X Clyde Zeiker

Improvement Permit by: E.C. Moore date 5-2-94

Authorization to Cover Existing System Inspection by: E.C. Moore date 5-2-94

Installed by: James Huddler

Certificate of Completion by: _____ date _____

Operation Permit by Mark Cox PS date 5-13-97

HEALTH DEPT COPY WHITE INSPECTION COPY (FINAL) GREEN OWNER COPY (FINAL) YELLOW INSPECTION COPY (INITIAL) PINK OWNER COPY (INITIAL) GOLD

to cover

Authorization to cover EXPIRES 60 MOS. from issue