IREDELL COUNTY HEALTH DEPARTMENT

Statesville Phone TR 3-7271 Mooresville Phone NO 3-1271

PERMIT TO INSTALL SEPTIC TANK

Permit No. _____ Permit Date _____ 19___

Owner H. M. Stamey Address Troy & Gilbert Road

Installed By S & D Contractor Address Jamestown, Road


Location of Property Troy & Gilbert Road

Tank		Capacity		Length of Lines		Fixtures	
Block	( )	1000	( )	225'	(✓)	No. of Baths	(✓)
Precast	( )	1250	( )	250'	( )	Dishwasher	( )
		1500	( )	Other _____		Garbage Grdr.	( )
		Other _____				Other _____	

NOTIFY HEALTH DEPARTMENT AT LEAST EIGHT HOURS BEFORE TANK IS TO BE INSPECTED.

Final Inspection 5/24/ 1965 Approved (✓) Disapproved ( )

Remarks _____

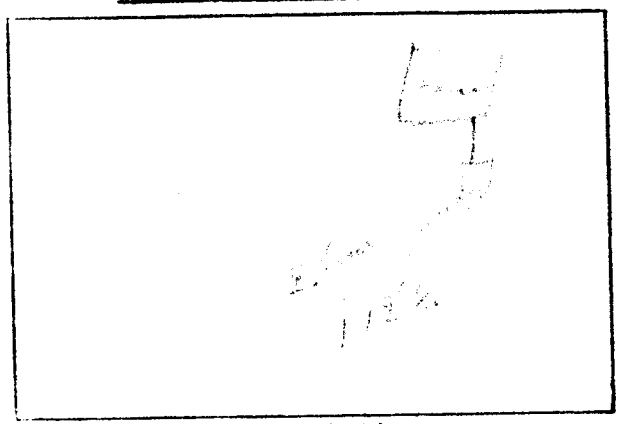

Sketch of Installation

540

Inspected by Thomas

Sanitarian