291

IREDELL COUNTY HEALTH DEPARTMENT

Statesville Phone TR 3-7271 Mooresville Phone NO 3-1271

PERMIT TO INSTALL SEPTIC TANK

Permit No. 1 Permit Date 4-8- 1968

Owner James Mowday Address R 6

Installed By Otto Lee Duncan Address Rt 5 Box 4


Location of Property Frye - Gilbert Rds

Tank		Capacity		Length of Lines		Fixtures	
Block	( )	1000	(✓)	225'	(✓)	No. of Baths	(1)
Precast	(✓)	1250	( )	250'	( )	Dishwasher	( )
		1500	( )	Other		Garbage Grdr.	( )
		Other				Other	

NOTIFY HEALTH DEPARTMENT AT LEAST EIGHT HOURS BEFORE TANK IS TO BE INSPECTED.

Final Inspection 4-8- 1968 Approved (✓) Disapproved ( )

Remarks

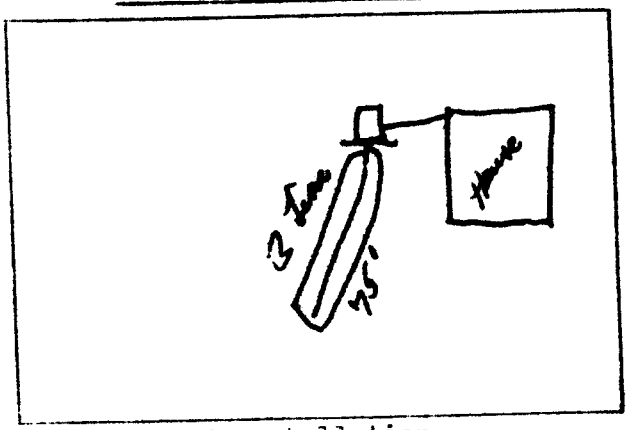

Sketch of Installation

FAIRVIEW CONCRETE AND LANDSCAPING CO.
Route #5, Box 49
Statesville, North Carolina 28677

Otto Lee Duncan

Sanitarian