IREDELL COUNTY HEALTH DEPARTMENT

Statesville Office (704) 878-5305 Mooresville Office (704) 660-3625 PERMIT # 223403

IMPROVEMENT PERMIT / AUTHORIZATION TO CONSTRUCT / OPERATION PERMIT / EXISTING SYSTEM

PIN # 4714629602

APPLICANT: CMH Homes APPLICANT ADDRESS: 2026 Northside Dr Statesville NC

SITE ADDRESS: 302 Ashbrook Rd Statesville NC PHONE: 704-873-2597 ALT. PHONE: 703-314-5328


SITE DIRECTIONS: 40W T/L Stamey Farm Rd T/R Ashbrook Lot is on left

SUBDIVISION: N/A SECTION: N/A LOT # N/A LOT AREA: 1ac DESIGN FLOW: 240 L.T.A.R.: Ex


Septic Tank	Ex (gal)	STB	Date	☐ New System ☐ Repair ☐ Expansion	System Type: I ☒ II III IV V VI	☒ Residence	No. Bedrooms 2	Water Supply
Pump Tank	(gal)	PT	Date	System Description: Existing		☐ Business	No. Persons 4	☐ Private
Pump Make	Model		Serial #	Repair System Description:		☐ Other	No. Employees	☒ Public
# Nitrification Fields	Ex # Lines Ex		Linear Ft: Ex	Maintenance Agreement Required:	☐ YES ☒ NO	☐ Slab	☒ Crawl Space	☐ Community
Trench Width	Ex Max. Trench Bottom Depth Ex		Gravel Depth Ex	☒ GRAVITY	☐ PRESSURE	☐ Basement w/plumbing		☐ Basement w/o plumbing

Comments / Conditions: All building foundations must be 55' from any part of STS.

INITIAL SITE SKETCH

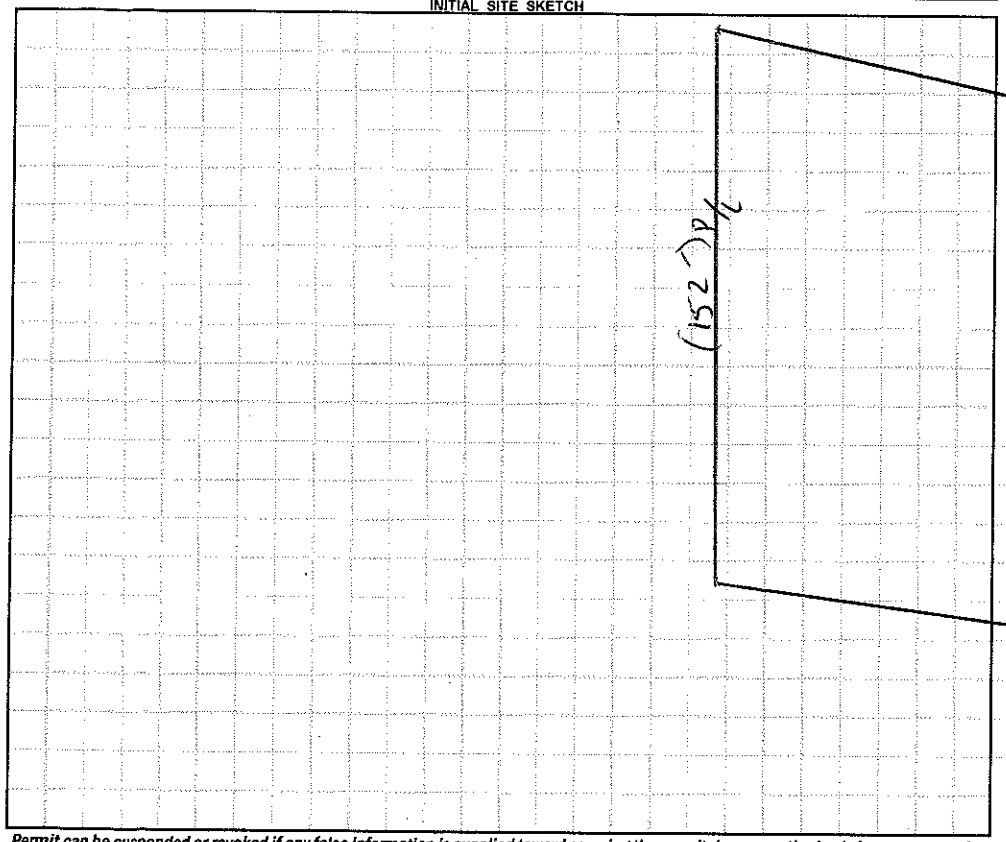

AS BUILT SKETCH

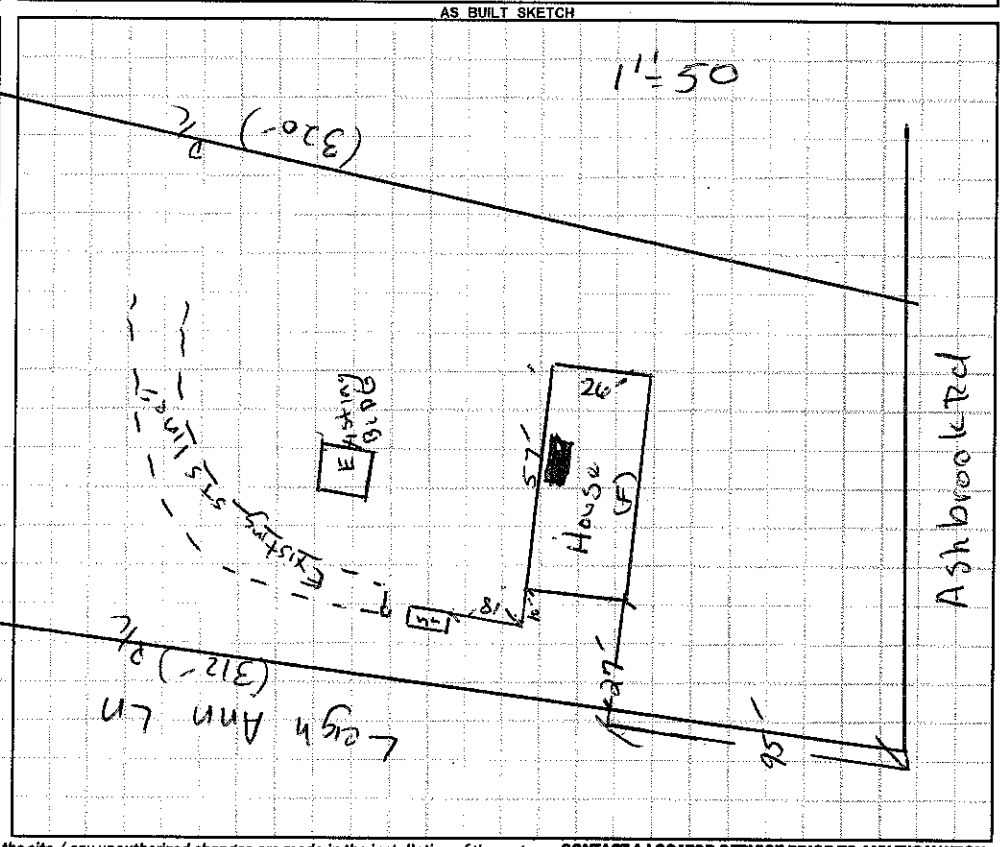

Permit can be suspended or revoked if any false information is supplied toward securing the permit / any unauthorized changes are made to the site / any unauthorized changes are made in the installation of the system. **CONTACT A LOCATOR SERVICE PRIOR TO ANY EXCAVATION**

☐ **IMPROVEMENT PERMIT** *with plat valid without expiration.* ☐ **IMPROVEMENT PERMIT** *with site plan valid for 60 mos.* ☐ **AUTHORIZATION TO CONSTRUCT** *valid for period equal to IMPROVEMENT PERMIT--not to exceed 60 mo.*

Owner / Applicant Signature: [signature] Date: 12-20-16 Installed by:

IMPROVEMENT PERMIT by: Date: OPERATION PERMIT by: Date:

AUTHORIZATION TO CONSTRUCT by: Date: Existing System Inspected by: [signature] Date: 12/16/16

Health Dept. Copy - WHITE Applicant (Final Approval) - YELLOW Applicant (Conditional Approval) - PINK