11830.

37842

IREDELL COUNTY HEALTH DEPARTMENT

(SEPTIC TANK) IMPROVEMENTS PERMIT AND CERTIFICATE OF COMPLETION
(Ground Absorption Sewage Disposal System -- G. S. Chapter 130-Article 13C)

OWNER OR CONTRACTOR WILLARD AUTON DATE 10-5-90 PERMIT NO. SL-A-43.

PHONE: Business _____ Home _____

LOCATION Island Ford Rd. off Hwy 90 W - ¼ mi. past Concord Bapt. Church on left. S. R. No. _____

SUBDIVISION NAME _____ LOT NO. _____ SECTION OR BLOCK NO. _____


House ( ) Mobile Home (✓) Business ( ) Other _____

No. Bedrooms 3 No. Bathrooms 2

Garbage Disposal Unit	Yes ( )	No (✓)	Character & Porosity of Soil	Prev. Suitable.
Auto. Dishwasher	Yes ( )	No (✓)	Percolation Rate	2-60 Min/Ft
Auto. Wash. Machine	Yes (✓)	No ( )	Topography	Level
Site Suitable	Yes (✓)	No ( )	Depth to Water Table	Not observed.
			Rock or other impervious formations	None observed.

Lot Area 100' x 200'

_____ Basement with Plumbing _____ Basement without Plumbing ✓ No Basement

 

Size of Tank 1000 Gals.

Nitrification Field: 4

No. of Lines 4

Sq. Ft. 300 Linear Ft. 300

Depth of Stone in Lines 12

Water Supply: Individual ( )
Public (✓)

Plan of System

Installed by Kenny Barnes

I understand and agree to install septic tank system as specified on this Improvements Permit.

Signed: _____

IMPROVEMENTS PERMIT BY Steve Brown

COMMENTS: _____

CERTIFICATE OF COMPLETION BY Steve Brown DATE 10-5-90

EXISTING SYSTEM CHECKED BY: _____ DATE _____

CONSTRUCTION MUST COMPLY WITH ALL OTHER APPLICABLE STATE AND LOCAL REGULATIONS.

Permit is VOID if any unauthorized changes are made in installation of system and/or if any false information is supplied in making Improvements Permit.

Health Dept. Copy: White Inspection Dept. Copy: Yellow Sanitarian's Copy: Pink Owner's Copy: Gold