## IREDELL COUNTY HEALTH DEPARTMENT

(SEPTIC TANK) IMPROVEMENTS PERMIT AND CERTIFICATE OF COMPLETION
(Ground Absorption Sewage Disposal System - G. S. Chapter 130-Article 13C)

OWNER OR CONTRACTOR Jerry Beatty DATE 2-18-74 PERMIT NO. _____

PHONE Business _____ Home _____

LOCATION Hwy # 90 - T.L. on Island Ford Rd - Cross Creek House on L. In Edge of Woods Past Command Baptist Church S. R. No. _____

SUBDIVISION NAME _____ LOT NO. _____ SECTION OR BLOCK NO. _____


House (✓) Mobile Home ( ) Business ( ) Other _____

No. Bedrooms 3 No. Bathrooms 2

| | | | |
|---|---|---|---|
| Garbage Disposal Unit | Yes (✓) | No (✓) | |
| Auto. Dishwasher | Yes (✓) | No (✓) | |
| Auto. Wash. Machine | Yes (✓) | No ( ) | |
| Site Suitable | Yes (✓) | No ( ) | |

Lot Area _____

Character & Porosity of Soil _____
Percolation Rate _____
Topography Existing System
Depth to Water Table _____
Rock or other impervious formations _____

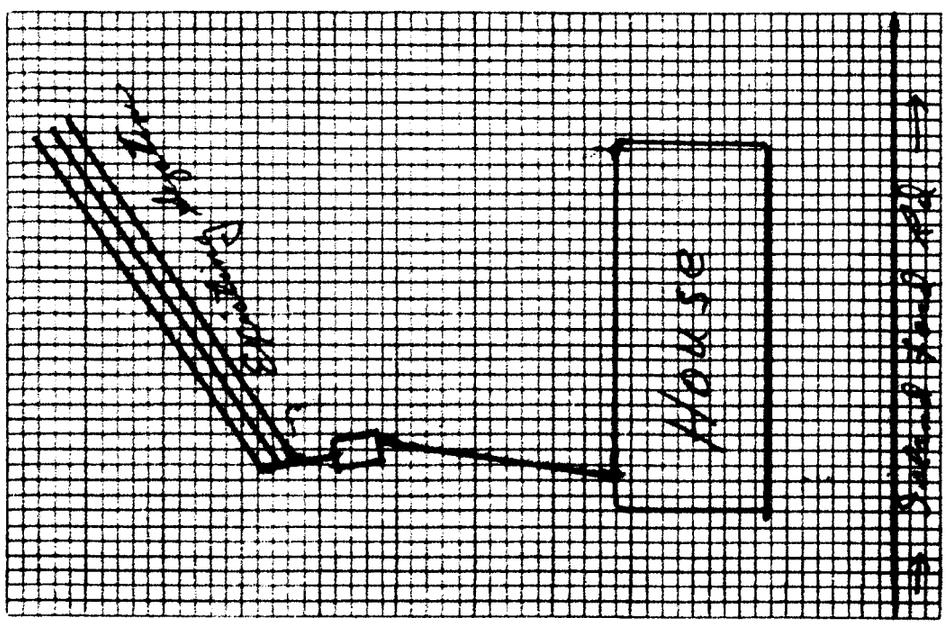


Plot of System

Size of Tank _____ Gals.
Nitrification Field:
No. of Lines _____
Sq. Ft. _____ Linear Ft. _____
Depth of Stone in Lines _____
Water Supply: Individual ( )
Public ( )

Installed by Lackey Bro

IMPROVEMENTS PERMIT BY House under Construction Prior to Sept 1. 1973

COMMENTS: This System Was installed in 1970 for a Trailer Mr Beatty has now built a house and Trailer is to be Moved. No Signs of any Septic Tank Trouble.

CERTIFICATE OF COMPLETION BY E. A. Stevenson DATE 2-18-74

CONSTRUCTION MUST COMPLY WITH ALL OTHER APPLICABLE STATE AND LOCAL REGULATIONS.

Health Dept. Copy: White Inspection Dept. Copy: Yellow Sanitarian's Copy: Pink Owner's Copy: Gold