IREDELL COUNTY HEALTH DEPARTMENT

STATESVILLE 704-878-5305 MOORESVILLE 704-664-5281

IMPROVEMENT PERMIT / AUTHORIZATION TO CONSTRUCT / OPERATION PERMIT / EXISTING SYSTEM INSPECTION

PERMIT# 073919 PIN# 4714 69 1902 DATE 6-12-98

OWNER OR CONTRACTOR WESLEY B. CRAWFORD PHONE: Business Home 873-8637

ADDRESS 295 LITTLE FARM ROAD, STATESVILLE, NC 28677

LOCATION NC90W, TL ISLAND FORD ROAD, TR CANNON ROAD, 5TH MH ON RIGHT

SUBDIVISION BLOCK / SECTION LOT LOT AREA 53.66 ACRES SITE CLASS. PS DESIGN FLOW 240 L.T.A.R. 0.30 GPD/SQ FT

Septic Tank: 1000 Gallons; STB 794 Date 4-23-98

Pump Tank: Gallons; PT Date

Pump Make: Model Serial No.

Nitrification Field: No Fields 1 Square Feet 810 Linear Feet 270

No Lines THREE Trench Width 36" Max Trench Bottom Depth 36" Gravel Depth 12"

☑ New System ☐ Repair System Type: I, II, III, IV, V, VI

System Description: CONVENTIONAL GRAVITY

Repair System Description: CONV. GRAVITY

Maintenance Agreement Required: ☐ Yes ☑ No

☐ House/Mod. Home ☑ Mobile Home ☐ Business ☐ Other

No. Bedrooms 3 No. Bathrooms 2 No. Employees

☐ Slab ☑ Crawl Space ☐ Basement w/plumbing ☐ Basement wo/plumbing


Water Supply: ☑ Individual ☐ Public ☐ Community WELL

Comments:/Conditions:

REPAIR AREA

SCALE: 1"=40'

INITIAL SITE SKETCH

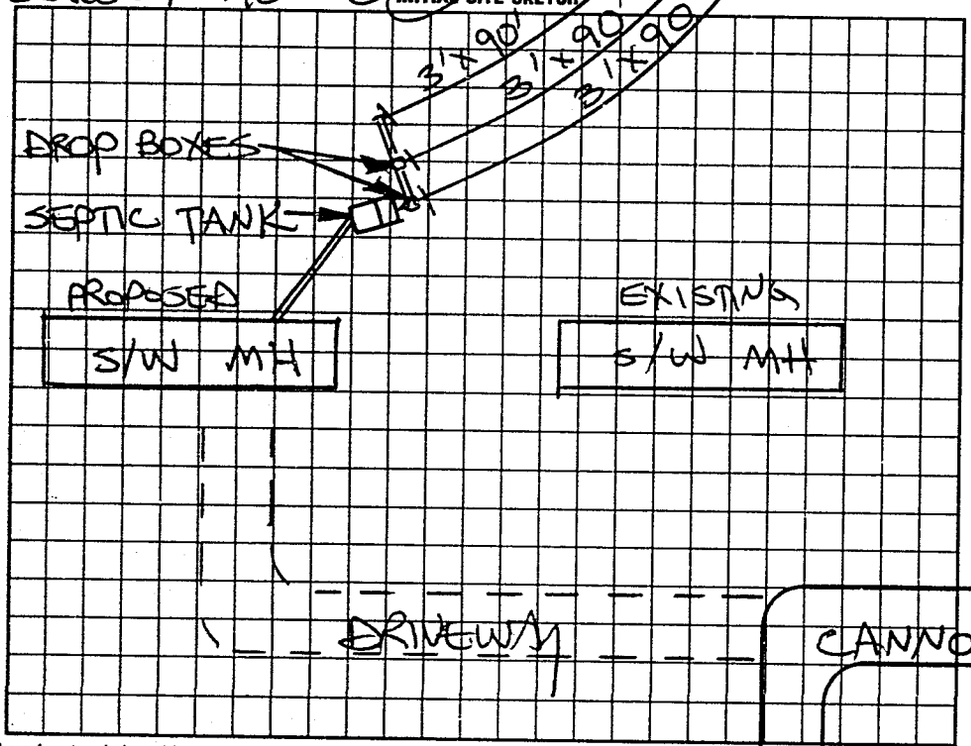

Comments:/Conditions:

AS BUILT SKETCH

I understand that this permit can be suspended or revoked if any false information is supplied toward securing the permit/any unauthorized changes are made to the site/any unauthorized changes are made in the installation of the system. Improvement Permit with plat valid without expiration. Improvement Permit with site plan valid for sixty months. Authorization to Construct is valid for a period equal to that of Improvement Permit – not to exceed sixty months.

Signed: Wesley Crawford date 6-13-98 Installed by: James Hudler

Improvement Permit by: STEVE HEDRICK date 6-12-98 Operation Permit by: Mat COJ RS date 6-30-98

Authorization to Construct by: STEVE HEDRICK date 6-12-98 Existing System Inspection by: date

HEALTH DEPT. COPY: WHITE INSPECTION COPY (FINAL): GREEN OWNER COPY (FINAL): YLLLOW INSPECTION COPY (INITIAL): PINK OWNER COPY (INITIAL): GOLD