IREDELL COUNTY HEALTH DEPARTMENT

Statesville Phone TR 3-7271 Mooresville Phone NO 3-1271

PERMIT TO INSTALL SEPTIC TANK

Permit NO. 51 Permit Date 8-10 1972

Owner JAMES HUDLEE Address R. STATESVILLE, NC

Installed By HENRY NORMAN Address STATESVILLE, NC.

Location of Property W. I-40. LEFT ON TRYE-GILBERT Rd.


TURN LEFT ON 1ST PAVED Rd - 2 Story House on LEFT

Tank		Capacity		Length of Lines		Fixtures	
Block	( )	1000	(✓)	225'	(✓)	No. of Baths	(✓)
Precast	(✓)	1250	( )	250'	( )	Dishwasher	( )
		1500	( )	Other		Garbage Grdr.	( )
		Other				Other	

NOTIFY HEALTH DEPARTMENT AT LEAST EIGHT HOURS BEFORE TANK IS TO BE INSPECTED.

Final Inspection 8-10 1972 Approved (✓) Disapproved ( )

Remarks

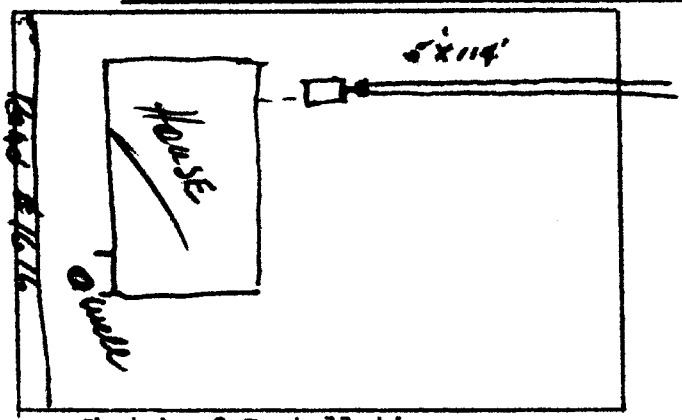

Sketch of Installation

G. D. Cross Hall

Sanitarian