# ICHD - ENVIRONMENTAL HEALTH DIVISION

Statesville Office (704) 878-5305 x3456 Mooresville Office (704) 660-3625

## SEPTIC: IMPROVEMENT PERMIT / AUTHORIZATION TO CONSTRUCT / OPERATION PERMIT / EXISTING SYSTEM

PERMIT : OSWP 2024-55435

PIN # 4714 -73 -5902

APPLICANT/OWNER: Charles Doss / Jessie Lentz APPLICANT ADDRESS: 463 Lentz Rd Statesville, NC 28625

SITE ADDRESS: 339 Gilbert Rd Statesville NC 28677 PHONE: 704-437-2620 ALT. PHONE


SITE DIRECTIONS: Stony Farm to Gilbert Site on Right SAP CONTROLLED: ☐ YES ☒ NO

SUBDIVISION: — SECTION: — LOT # — LOT AREA: 2.73 DESIGN FLOW: 360gpd L.T.A.R (Initial): EXT L.T.A.R (Repair): EXT

| | | | | | | | | | | | |
|---|---|---|---|---|---|---|---|---|---|---|---|
| Septic Tank | 1000 | (gal) | STB | 7160 | Date | | ☐ New System | ☒ Repair | ☐ Expansion | System Type: I II III IV V VI | ☒ Residence | No. Bedrooms | 3 | Water Supply |
| Pump Tank | - | (gal) | PT | - | Date | - | System Description: | | | | ☐ Business | No. Persons | 2 | ☐ Private |
| Pump Make | - | Model | - | Serial # | - | | Repair System Description: | Tank Replacement | | | ☐ Other | No. Employees | | ☒ Public |
| # Nitrification Fields | EXT | # Lines | EXT | Linear Ft | EXT | | Maintenance Agreement Required: | ☐ YES | ☒ NO | | ☐ Slab | ☐ Crawl Space | | ☐ Community |
| Trench Width | EXT | *Max. Trench Depth(Initial) | EXT | *Max. Trench Depth(Repair) | EXT | Gravel Depth | EXT | ☒ GRAVITY | ☐ PRESSURE | | ☐ Basement w/plumbing | ☐ Basement w/o plumbing | | |
| * Measured on the downhill side of the trench | | Effluent Standard: | ☒ DSE | ☐ HSE | ☐ TS-I | ☐ TS-II | ☐ RCW | ☐ NSF/ANSI 40 | Usable Depth to LC (Initial): | EXT | Usable Depth to LC (Repair): | EXT | Limiting Condition | |

Comments / Conditions: Pump / Crush / Fill Old Septic Tank - Replace with new 1000 gallon Septic tank. Inspect & Replace D-Box if necessary.

INITIAL SITE SKETCH

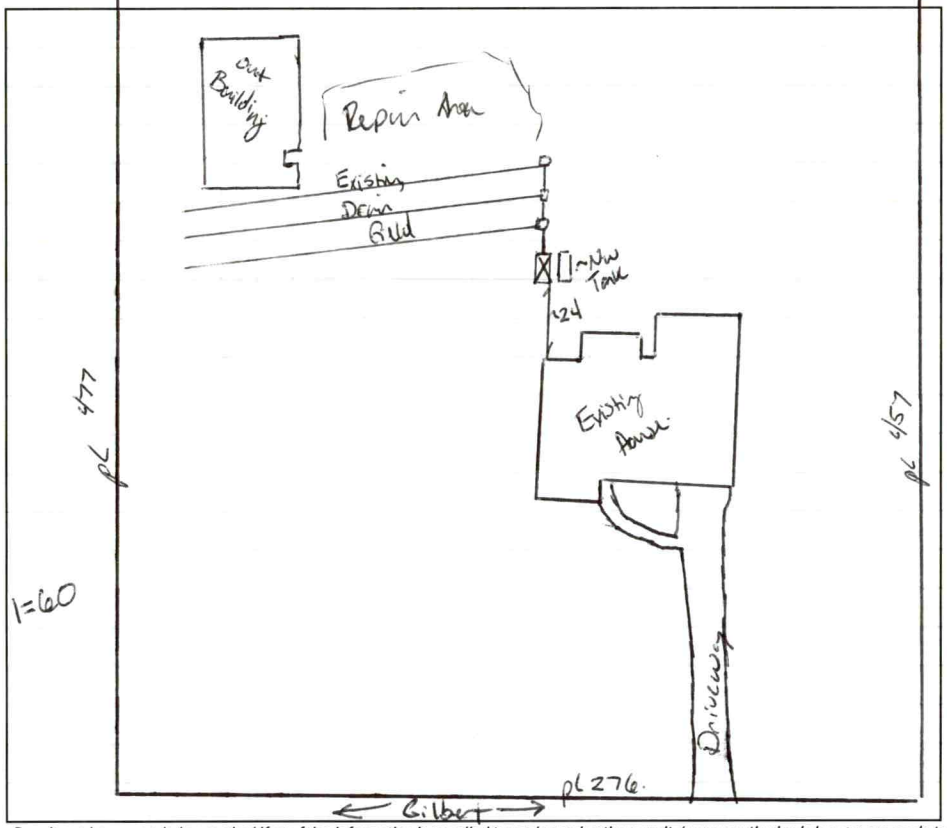


AS BUILT SKETCH

FOR SEPTIC FINAL INSPECTION CALL: 704-664-3703 between 8am-9am

the day the inspection is needed. Be sure to speak with an inspector to confirm your time.

new drop boxes set

*Permit can be suspended or revoked if any false information is supplied toward securing the permit / any unauthorized changes are made to the site / any unauthorized changes are made in the installation of the system.* **CONTACT A LOCATOR SERVICE PRIOR TO ANY EXCAVATION**

☐ **IMPROVEMENT PERMIT** *with plat valid without expiration.* ☒ **IMPROVEMENT PERMIT** *with site plan valid for 60 mos.* ☒ **AUTHORIZATION TO CONSTRUCT** *valid for period equal to IMPROVEMENT PERMIT--not to exceed 60 mo.*

Owner / Applicant Signature: Date: Installed by: Lentz

IMPROVEMENT PERMIT by: Brian A Bates Date: 6/26/2024 OPERATION PERMIT by: D. Wieberg Date: 7/3/24

AUTHORIZATION TO CONSTRUCT by: Brian A Bates Date: 6/26/2024 Existing System Inspected by: Date:

| Item | Date | Initials |
|---|---|---|
| Drain Lines Checked | | |
| Tanks Checked | | |
| Pressure Manifold or Valve Box Checked | | |
| Pressure Head Set | | |
| Electrical Checked | | |
| Floats Set | | |
| Alarm Checked | | |
| Maintenance Contract Needed? Y / N | | |
| Comments: | | |
| | | |
| | | |

| Repairs Only | |
|---|---|
| | State Code |
| Failing System Code | |
| Type of Distribution | G or P |
| Type of Failure/Malfunction | |
| Primary Cause of Failure/Malfunction | |
| | |
| Age of System? _____ | |
| Initial or Repair? _____ | |

# PERMIT SNAPSHOT REPORT OSWP-2024-55835 FOR IREDELL COUNTY

| | | | | | |
|---|---|---|---|---|---|
| **Permit Type** | Environmental Health OSWP | **Project:** | | **App Date:** | 06/18/2024 |
| **Work Class:** | EH Septic Permit | **District:** | Iredell County | **Exp Date:** | NOT AVAILABLE |
| **Status:** | PRIORITY PERMIT | **Square Feet:** | 0.00 | **Completed:** | NOT COMPLETED |
| **Valuation:** | $0.00 | **Assigned To:** | Botkins, Ben | **Approval Expire Date:** | |
| **Description:** | PRIORITY PERMIT -- REPAIR | Septic tank has collapsed. | | | |

| | | |
|---|---|---|
| **Parcel:** 4714735902.000 Main | **Address:** 339 Gilbert Rd Statesville, NC 28677 Main | **Zone:** R-20(Suburban Residential District) |

| Property Owner | Applicant/Authorized Agent | Applicant/Authorized Agent |
|---|---|---|
| Charles Doss | Jeanie Lentz | Jeanie Lentz |
| Home: (704) 437-2620 | Home: (980) 829-3278 | 463 Lentz Road<br>Statesville, NC 28625 |

**Permit Custom Fields**

| | | | | | |
|---|---|---|---|---|---|
| How is your site plan being submitted | Custom Site Plan | Septic Application/Permit Type | Repair | Does the site contain any jurisdictional wetlands | No |
| Non-domestic Sewage Generated | No | Other Public Agency | No | All proposed structure dimensions | N/A |
| What are the proposed structures | Other Addition/Structure | Maximum Number of Bedrooms | 3 | If other Addition/Structure, please explain | |
| Number of Occupants | 2 | Foundation Type | Basement with Plumbing | Water Supply | Other Public Water |
| Desired Septic System Type | No Preference | If other septic system type, please explain | | Pump Make | |
| # of Nitrification Fields | | Model | | Serial # | |
| System Description | | Repair System Description | | Comments/Conditions | |
| Permit type(s) | Authorization to Construct | Additional Unique Setbacks Apply | No | | |

| Attachment File Name | Added On | Added By | Attachment Group | Notes |
|---|---|---|---|---|
| Signature_Jeanie_Lentz_6/18/2024.jpg | 06/18/2024 15:49 | Lentz, Jeanie | | Uploaded via CSS |
| 339 GILBERT RD ORIGINAL SEPTIC PERMIT 1995.pdf | 06/19/2024 9:22 | COMEAUX, DEBRA | Available Online | ORIGINAL SEPTIC PERMIT 1995 |
| 339 Gilbert Rd AC_v1.pdf | 06/19/2024 9:22 | Lentz, Jeanie | Available Online | |
| 339 Gilbert Rd Site Plan_v1.pdf | 06/19/2024 9:22 | Lentz, Jeanie | Available Online | |

| Workflow Step / Action Name | Action Type | Start Date | End Date |
|---|---|---|---|
| **Application Completeness Check v.1** | | 06/19/2024 9:22 | 06/19/2024 9:24 |
| Confirm application complete v.1 | Generic Action | | 06/19/2024 9:24 |
| ~~**Zoning Review v.1**~~ | | | 06/19/2024 9:22 |
| ~~Floodplain Admin Overview v.1~~ | Task | | 06/19/2024 9:22 |
| ~~Issue Invoice v.1~~ | Generic Action | | 06/19/2024 9:22 |
| ~~Fees Paid v.1~~ | Generic Action | | 06/19/2024 9:22 |
| Fees v.1 | | | |
| Issue Invoice v.1 | Generic Action | | |
| Fees Paid v.1 | Generic Action | | |
| ~~**Lot Readiness Verification v.1**~~ | | | 06/19/2024 9:23 |
| ~~OSWP Septic Preliminary Site Visit v.1~~ | Inspection | | 06/19/2024 9:23 |
| ~~OSWP Site Evaluation v.1~~ | Inspection | | 06/19/2024 9:23 |