IREDELL COUNTY HEALTH DEPARTMENT

STATESVILLE 704-878-5305 MOORESVILLE 704-664-5281

IMPROVEMENT PERMIT / AUTHORIZATION TO CONSTRUCT / OPERATION PERMIT / EXISTING SYSTEM INSPECTION

PERMIT# X PIN# 4714 74 6429 DATE

OWNER OR CONTRACTOR Jimmy + Diana Levan PHONE: Business (704) 896-4665 Home (704) 878-6369

ADDRESS 332 Gilbert Rd Statesville

LOCATION Stamey Farm Rd To Gilbert Rd 4th home on Left 332 on Mail box

SUBDIVISION ^ BLOCK / SECTION ^ LOT ^ LOT AREA 3.04 ACRES SITE CLASS. LS DESIGN FLOW 360 L.T.A.R. .3

Septic Tank: Existing Gallons; STB Date

Pump Tank: Gallons; PT Date

Pump Make: Model Serial No

Nitrification Field: No Fields 1 Square Feet 1200 Linear Feet 300

No Lines 4 Trench Width 36" Max Trench Bottom Depth 36?

☐ New System ☒ Repair System Type: I. II. (III.) IV. V. VI

System Description:

Repair System Description: Gravity [redacted] 25% Red.

Maintenance Agreement Required: ☐ Yes ☒ No

Gravel Depth 6" Sand

☒ House/Mod. Home ☐ Mobile Home ☐ Business ☐ Other

No. Bedrooms 3 No. Bathrooms 2 No. Employees


☐ Slab ☒ Crawl Space ☐ Basement w/plumbing ☐ Basement wo/plumbing

Water Supply: ☐ Individual ☒ Public ☐ Community


Comments:/Conditions: Install Lines on contour
50 chambers or 30 H/S systems
May install Bull Run Valve To Salvage old system & other at Nand Box by Tank. Recommend Diverting Gutter Drains

Comments:/Conditions: NEW SANITARY TEE INSTALLED IN SEPTIC TANK
Drains Located
Backfill Crawl Space drain if found

INITIAL SITE SKETCH

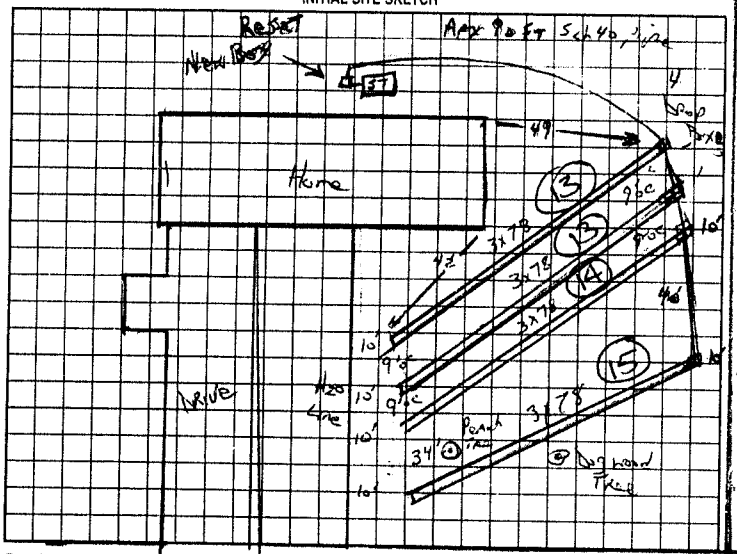

AS BUILT SKETCH

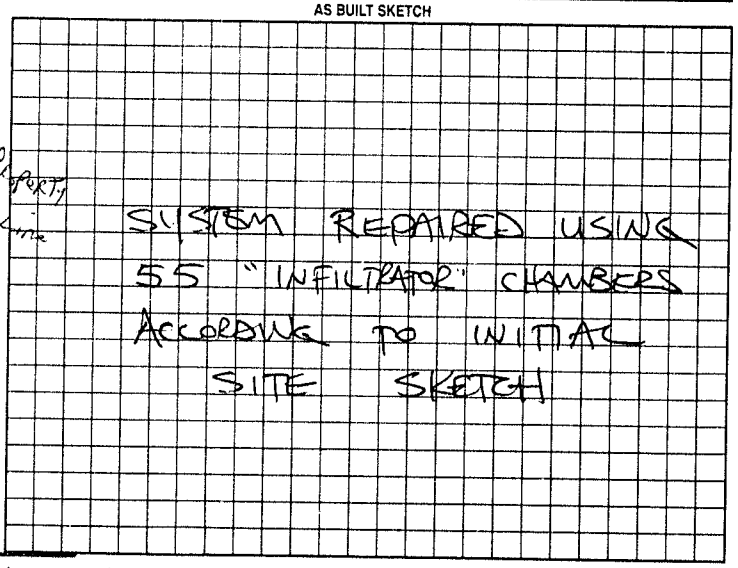

Permit can be suspended or revoked if any false information is supplied toward securing the permit/any unauthorized changes are made to the site/any unauthorized changes are made in the installation of the system. Improvement Permit with plat valid without expiration. Improvement Permit with site plan valid for sixty months. Authorization to Construct is valid for a period equal to that of Improvement Permit – not to exceed sixty months.

Signed: Jimmy Levan date 4-19-99

Improvement Permit by: Jo Potter date 4-19-99

Authorization to Construct by: Jo Potter date 4-19-99

Installed by: WES LYTTON

Operation Permit by: STEVE HEDRICK date 8-15-01

Existing System Inspection by: date

HEALTH DEPT. COPY: WHITE OWNER COPY (FINAL): YELLOW OWNER COPY (INITIAL): PINK