IREDELL COUNTY HEALTH DEPARTMENT

STATESVILLE 704-878-5305 (01) MOORESVILLE 704-664-5281

IMPROVEMENT PERMIT / AUTHORIZATION TO CONSTRUCT / OPERATION PERMIT / EXISTING SYSTEM INSPECTION

PERMIT# 122824 PIN# 4714-77-7073-01 6473 DATE 8/12/04

OWNER OR CONTRACTOR Larry Curtis PHONE: Business Home (704) 872-9064

ADDRESS 631 Island Ford Rd. Statesville, N.C. 28625

LOCATION I-40W, Exit Hwy 90 (#146), turn right on Hwy 90, (L) Island Ford Rd, ON Left across from Commans Baptist Church

SUBDIVISION BLOCK / SECTION LOT LOT AREA 0.962 Ac SITE CLASS. #5 DESIGN FLOW 360 L.T.A.R. .25gpd/ft2

Septic Tank: 1000 Gallons; STB 1012 Date 7-11-04
Pump Tank: Gallons; PT Date
Pump Make: Model Serial No.
Nitrification Field: No Fields 1 Square Feet 1440 Linear Feet 480
No Lines 6@80' Trench Width 36" Max Trench Bottom Depth 36" Gravel Depth 12"

☒ New System ☐ Repair System Type: I, II, III, IV, V, VI
System Description: Gravity, Conventional
Repair System Description: Gravity, Conventional
Maintenance Agreement Required: ☐ Yes ☐ No


☒ House/Mod. Home No. Bedrooms 3
☐ Mobile Home No. Bathrooms
☐ Business No. Employees
☐ Other
☐ Slab ☒ Crawl Space ☐ Basement w/plumbing ☐ Basement wo/plumbing

Water Supply: ☐ Individual ☒ Public ☐ Community

Comments:/Conditions: (1) Install lines on Contour (2) Do Not install when wet (3) Install one (1) Flow Divider tee w/5 drop boxes.

Comments:/Conditions: SEPTIC TANK WITH MARKER INSTALLED USING "TUFTITE" FILTER

INITIAL SITE SKETCH

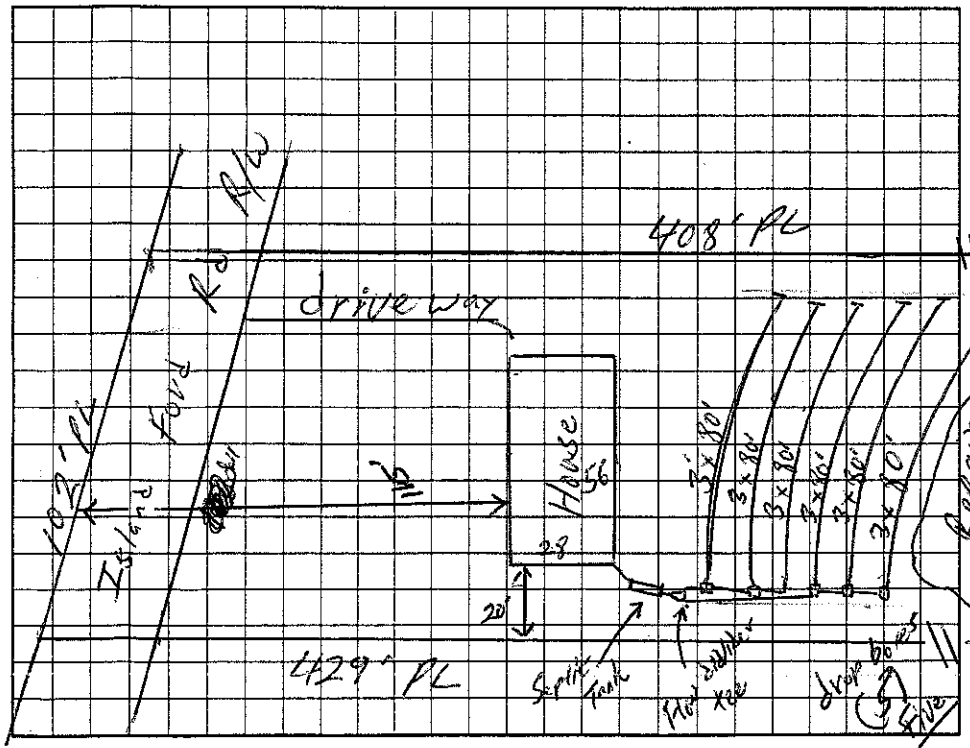

AS BUILT SKETCH

SYSTEM INSTALLED ACCORDING TO INITIAL SITE SKETCH

Permit can be suspended or revoked if any false information is supplied toward securing the permit/any unauthorized changes are made to the site/any unauthorized changes are made in the installation of the system. Improvement Permit with plat valid without expiration. Improvement Permit with site plan valid for sixty months. Authorization to Construct is valid for a period equal to that of Improvement Permit – not to exceed sixty months.

Signed: Larry L. Curtis date 8/12/04 Installed by: A-1 BACKHOE

Improvement Permit by: William O. Johnson date 8/12/04 Operation Permit by: STEVE HENDRICK date 1-11-05

Authorization to Construct by: William O. Johnson date 12/21/04 Existing System Inspection by: date

HEALTH DEPT. COPY: WHITE OWNER COPY (FINAL): YELLOW OWNER COPY (INITIAL): PINK