IREDELL COUNTY HEALTH DEPARTMENT

Statesville Phone TR 3-7271 Mooresville Phone NO 3-1271

PERMIT TO INSTALL SEPTIC TANK

Permit No. 154 Permit Date 9-20 1972

Owner Command Baptist Church Address Statesville NC

Installed By P & M Construction Co Address Statesville NC


Location of Property Out Hwy # 90 to Island Ford Rd. T.L. Church on Right after you Cross 3rd Creek

Tank		Capacity		Length of Lines		Fixtures	
Block	( )	1000	(✓)	225'	(✓)	No. of Baths	(2)
Precast	(✓)	1250	( )	250'	( )	Dishwasher	( )
		1500	( )	Other		Garbage Grdr.	( )
		Other				Other	

NOTIFY HEALTH DEPARTMENT AT LEAST EIGHT HOURS BEFORE TANK IS TO BE INSPECTED.

Final Inspection 9-20 1972 Approved (✓) Disapproved ( )

Remarks Water from Well at Church -

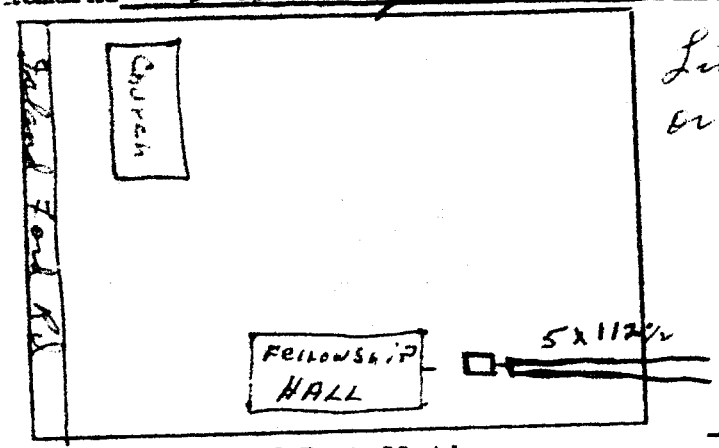

Sketch of Installation

Lines are approx 3' deep or more in Place

E. G. Stevenson

Sanitarian