IREDELL COUNTY HEALTH DEPARTMENT

STATESVILLE 704-878-5305 (aw) (ab) MOORESVILLE 704-664-5281 (RB)

IMPROVEMENT PERMIT / AUTHORIZATION TO CONSTRUCT / OPERATION PERMIT / EXISTING SYSTEM INSPECTION

PERMIT # 158074 PIN # 4715706 ### 1596 DATE 10-27-09

OWNER or APPLICANT Billy Little PHONE: Business Home: 704-528-1504

OWNER or APPLICANT ADDRESS 165 Quarter horse Lane Statesville NC 28625

LOCATION / DIRECTIONS Valeria Ford RD (R) Cannon (R) Quarterhorse LN at culdesac

SUBDIVISION BLOCK / SECTION LOT # LOT AREA 2.3 DESIGN FLOW 360 L.T.A.R. 125

Septic Tank 1000 Gallons: STB 760 Date 9-17

Pump Tank Gallons: P T Date

Pump Make Model Serial #

Nitrification Field No Fields No Lines 4 Linear Feet 360

Trench Width 36" Max. Trench Bottom Depth 36" Gravel Depth NA

☑ New System ☐ Repair ☐ Expansion System Type I II III IV V VI

System Description: 25% Conv.

Repair System Description: 25% Conv.

Maintenance Agreement Required ☐ YES ☑ NO

☑ GRAVITY ☐ PRESSURE

☑ Residence No. Bedrooms 3

☐ Business No. Persons

☐ Other No. Employees

☐ Slab ☐ Crawl Space


☑ Basement w/plumbing ☐ Basement w/o plumbing

Water Supply: ☑ Private ☐ Public ☐ Community

Comments / Conditions

(1" = 100')


INITIAL SITE SKETCH

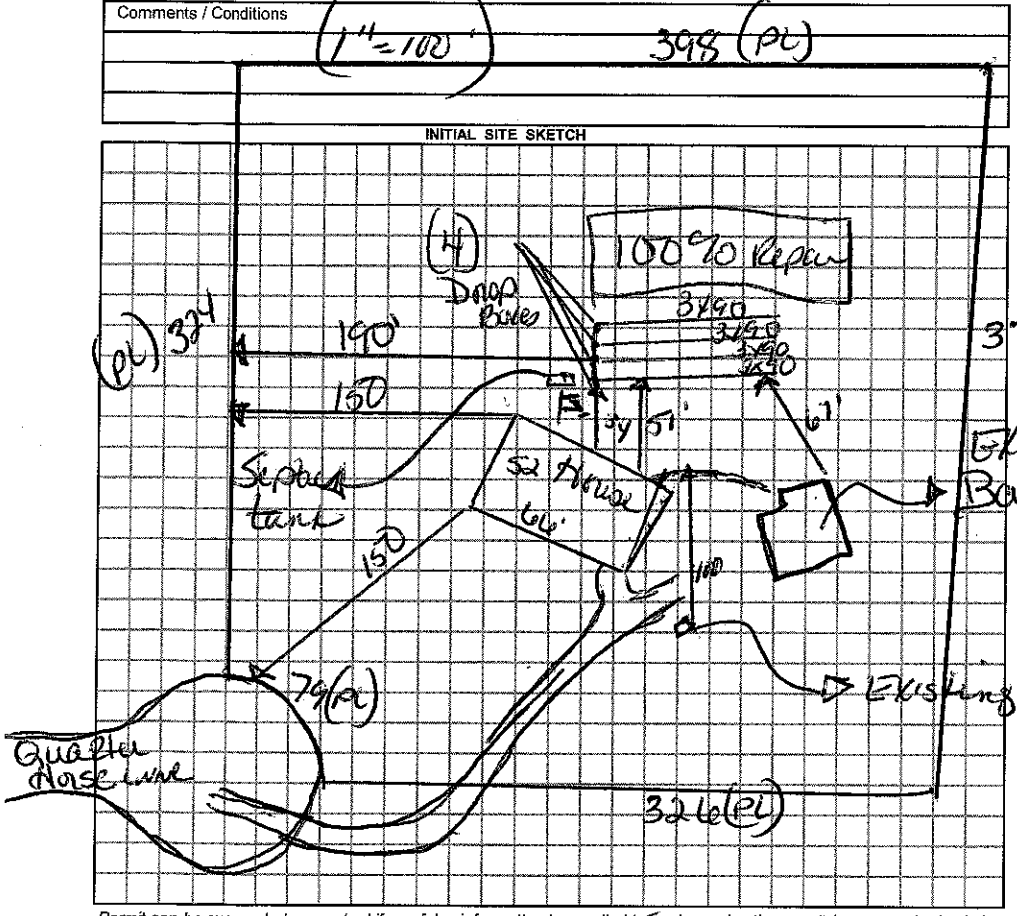

Comments / Conditions

* 36" Trench Bottom
Install on Contour
Maintain all setbacks

AS BUILT SKETCH

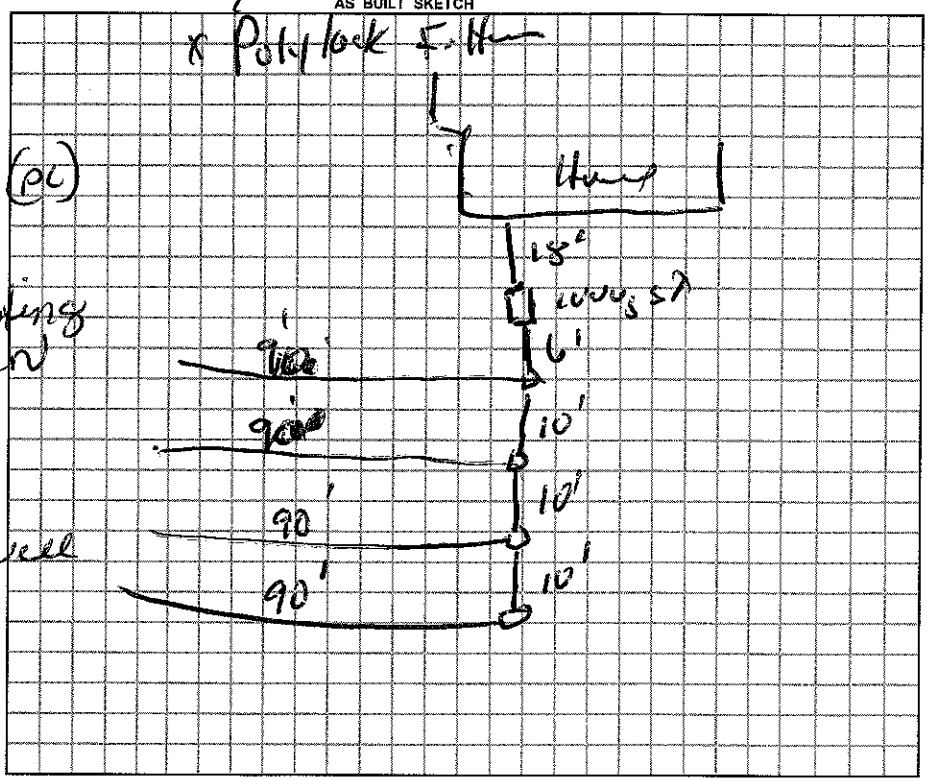

Permit can be suspended or revoked if any false information is supplied toward securing the permit / any unauthorized changes are made to the site / any unauthorized changes are made in the installation of the system.

☐ *IMPROVEMENT PERMIT w / plat valid without expiration.* ☑ *IMPROVEMENT PERMIT w / site plan valid for 60 mos.* ☑ *AUTHORIZATION TO CONSTRUCT valid for period equal to IMPROVEMENT PERMIT-not to exceed 60 mo.*

Owner / Applicant Signature: Billy Little Date 11-4-09

Improvement Permit by: Kelly Cook Date 10-27-09

Authorization to Construct by: Kelly Cook Date 10-27-09

YOU SHOULD CONTACT A LOCATOR SERVICE PRIOR TO ANY EXCAVATION.

Installed by: Bryant Gallihar

Operation Permit by: R.S. Date: 7 April 10

Existing System Inspected by: Date:

WHITE COPY Environmental Health YELLOW COPY (Final) Owner / Applicant PINK COPY (Initial) Owner / Applicant