IREDELL COUNTY HEALTH DEPARTMENT

STATESVILLE 704-878-5305 MOORESVILLE 704-664-5281

IMPROVEMENT PERMIT / AUTHORIZATION TO CONSTRUCT / OPERATION PERMIT / EXISTING SYSTEM INSPECTION

PERMIT# Repair PIN# 4714844434

OWNER OR APPLICANT Ray Benfield

ADDRESS 302 Gilbert Rd PHONE: Business _____ Home 704-871-0614 DATE 8-27-08

LOCATION 40 W to (L) on Stoney, (L) on Gilbert

SUBDIVISION n/a BLOCK / SECTION _____ LOT _____ LOT AREA Ex SITE CLASS. Ex. DESIGN FLOW 360 L.T.A.R. Ex.

Septic Tank: 1000 Gallons; STB 1007 Date 5-26-08

Pump Tank: _____ Gallons; PT _____ Date _____

Pump Make: _____ Model _____ Serial No. _____

Nitrification Field: No Fields ___ Square Feet Ex Linear Feet Ex

No Lines Ex Trench Width Ex Max Trench Bottom Depth Ex Gravel Depth Ex

☒ New System ☐ Repair ☐ Expansion System Type: I (II) III IV V VI

System Description: _____

Repair System Description: Replace or Repair

Maintenance Agreement Required: ☐ Yes ☐ No

☒ House/Mod. Home No. Bedrooms 3

☐ Mobile Home No. Persons ___

☐ Business No. Employees ___

☐ Other _____

Water Supply: ☒ Individual ☐ Public ☐ Community


☐ Slab ☒ Crawl Space ☐ Basement w/plumbing ☐ Basement wo/plumbing

Comments:/Conditions:


If replacement lid found - may be used. otherwise replace tank

Comments:/Conditions:

INITIAL SITE SKETCH

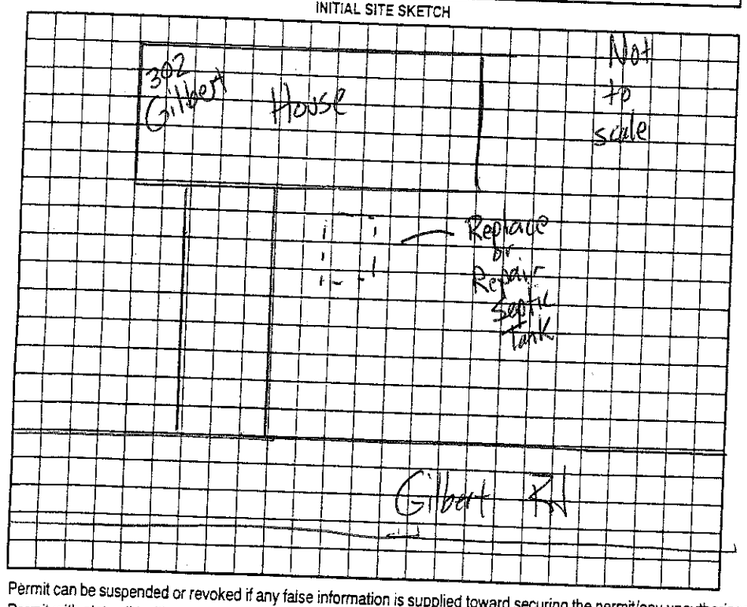

AS BUILT SKETCH

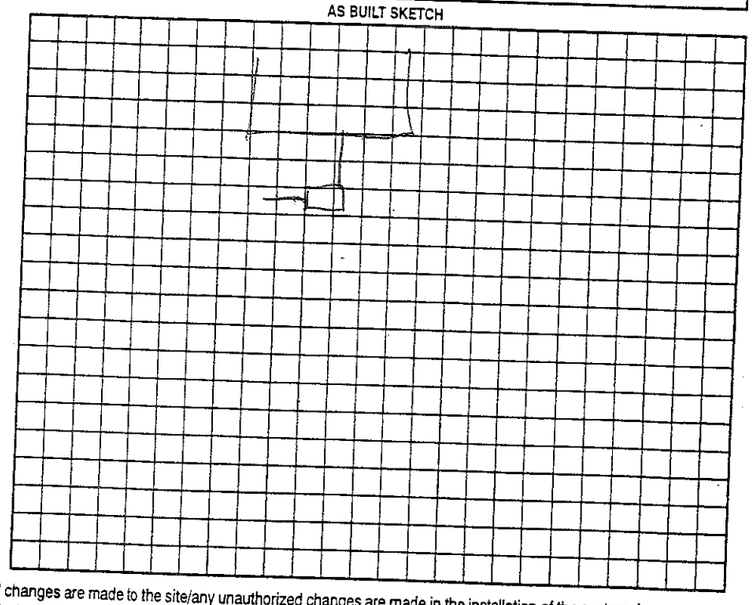

Permit can be suspended or revoked if any false information is supplied toward securing the permit/any unauthorized changes are made to the site/any unauthorized changes are made in the installation of the system. Improvement Permit with plat valid without expiration ☐ Improvement Permit with site plan valid for sixty months ☒ Authorization to Construct is valid for a period equal to that of Improvement Permit – not to exceed sixty months.

Signed: E. Ray Benfield

Improvement Permit by: _____ date _____

Authorization to Construct by: _____ date 8-27-08

Installed by: Wes Lytton

Operation Permit by: _____ date 9-11-08

Existing System Inspection by: _____ date _____

HEALTH DEPT. COPY: WHITE OWNER COPY (FINAL): YELLOW OWNER COPY (INITIAL): PINK