IREDELL COUNTY HEALTH DEPARTMENT

STATESVILLE 704-878-5305 EJ MOORESVILLE 704-664-5281

IMPROVEMENT PERMIT / AUTHORIZATION TO CONSTRUCT / OPERATION PERMIT / EXISTING SYSTEM INSPECTION

PERMIT# 109192 PIN# 4774-84-5490 DATE 10/25/02

OWNER OR CONTRACTOR Brett Rainwater PHONE: Business — Home 704-873-6110

ADDRESS 300 Walnut Tree Road Statesville N.C. 28625

LOCATION I-40 W, (L) on Stamey Farm Rd (L) on Gilbert Road, Property on left.

SUBDIVISION PRICE BLOCK / SECTION — LOT 9 LOT AREA 2.74 Ac. SITE CLASS. PS DESIGN FLOW 480 L.T.A.R. .30 gpd/ft²

Septic Tank: 1500 Gallons; STB 1012 Date 2-1-04 — Septic Tank: 1,000
Pump Tank: 1,000 Gallons; PT — Date —
Pump Make: — Model — Serial No. —
Nitrification Field: No Fields 1 Square Feet 1600 Linear Feet 534
No Lines 5 Trench Width 36" Max Trench Bottom Depth 30" Gravel Depth 12"

☒ New System ☐ Repair System Type: I (II) III, IV, V, VI
System Description: Gravity, Conventional
Repair System Description: Gravity, 25% Red
Maintenance Agreement Required: ☐ Yes ☒ No

☒ House/Mod. Home No. Bedrooms 4
☐ Mobile Home No. Bathrooms 3
☐ Business No. Employees —
☐ Other —


☐ Slab ☒ Crawl Space ☒ Basement w/plumbing ☐ Basement wo/plumbing

Water Supply: ☐ Individual ☒ Public ☐ Community


Comments/Conditions: (1) Install lines on Contour (2) Maintain proper setbacks (3) Install Subsurface (French) Drain as shown 48" Deep to daylight (4) Install 2nd Tank for basement plumbing only

Comments/Conditions: Crawl Space House, No Basement, (1) Only S.T. needed. ins 12/3/03 — Taff-Tite Filter & ST Marker Installed

INITIAL SITE SKETCH (Not to Scale)

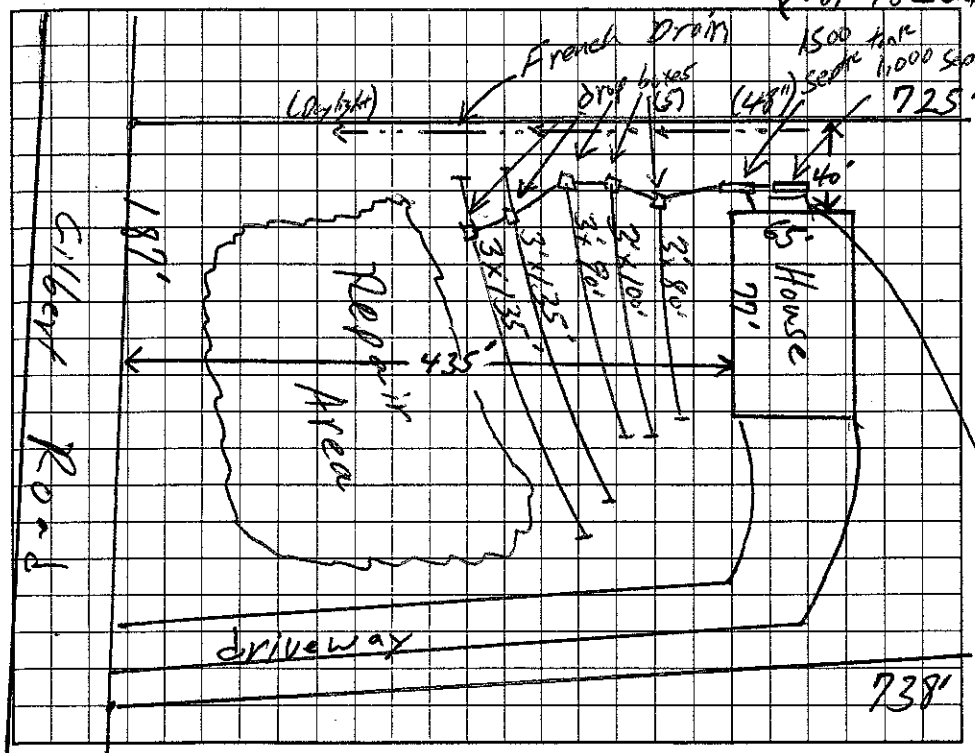

AS BUILT SKETCH (Not To Scale)

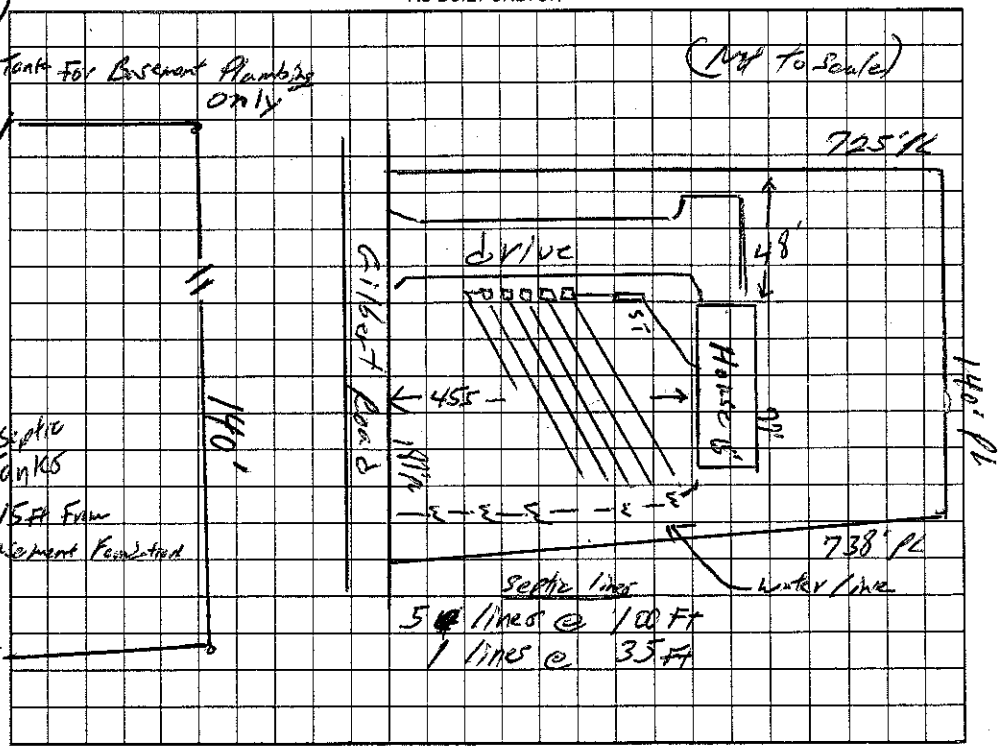

Permit can be suspended or revoked if any false information is supplied toward securing the permit/any unauthorized changes are made to the site/any unauthorized changes are made in the installation of the system. Improvement Permit with plat valid without expiration. Improvement Permit with site plan valid for sixty months. Authorization to Construct is valid for a period equal to that of Improvement Permit – not to exceed sixty months.

Signed: Brett Rainwater date 11/1/02 Installed by: Steve Jordan

Improvement Permit by: William O. Johnson date 10/30/02 Operation Permit by: William O. Johnson date 6/30/04

Authorization to Construct by: William O. Johnson date 12/3/03 Existing System Inspection by: — date —

HEALTH DEPT. COPY: WHITE OWNER COPY (FINAL): YELLOW OWNER COPY (INITIAL): PINK