IREDELL COUNTY HEALTH DEPARTMENT

Statesville Office (704) 878-5305 | Mooresville Office (704) 660-3625 PERMIT # 208065

IMPROVEMENT PERMIT / AUTHORIZATION TO CONSTRUCT / OPERATION PERMIT / EXISTING SYSTEM

PIN # 4714845490

APPLICANT: Brigid Hess APPLICANT ADDRESS: 294 Gilbert Rd Statesville NC 28677

SITE ADDRESS: 294 Gilbert Rd Statesville NC 28677 PHONE: 704-929-5402 ALT. PHONE: N/A

SITE DIRECTIONS: 40 W to exit 148 T/L Stamey Farm Rd T/L Gilbert Rd house on left

SUBDIVISION: N/A SECTION: N/A LOT # N/A LOT AREA: 2.74 ac DESIGN FLOW: 480 L.T.A.R.: Ex

Septic Tank Ex (gal) STB Date

Pump Tank (gal) PT Date

Pump Make Model Serial #

Nitrification Fields Ex # Lines Ex Linear Ft: Ex

Trench Width Ex Max. Trench Bottom Depth Ex Gravel Depth Ex

☐ New System ☐ Repair ☐ Expansion System Type: I ☒ II III IV V VI

System Description: Existing

Repair System Description:

Maintenance Agreement Required: ☐ YES ☒ NO

☑ GRAVITY ☐ PRESSURE

☒ Residence No. Bedrooms 4

☐ Business No. Persons 8

☐ Other No. Employees


☐ Slab ☒ Crawl Space

☐ Basement w/plumbing ☐ Basement w/o plumbing


Water Supply: ☐ Private ☒ Public ☐ Community

Comments / Conditions: All building foundations must be 55' from any part of STS.

INITIAL SITE SKETCH

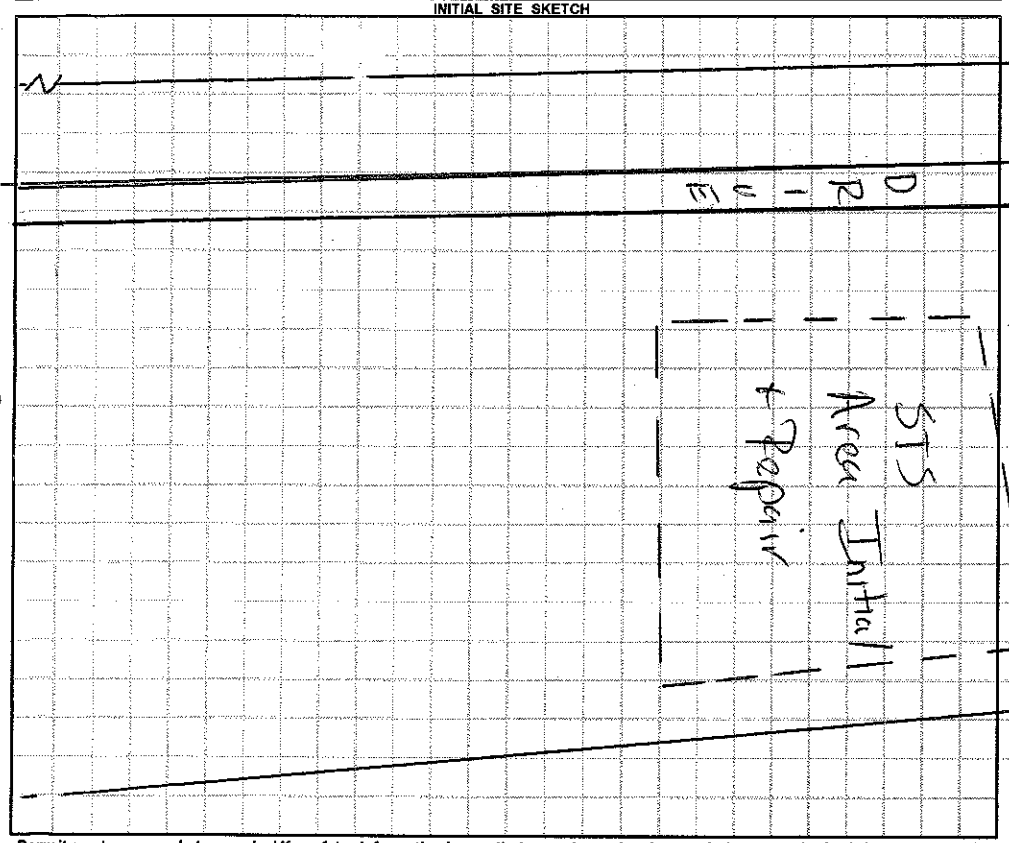

AS BUILT SKETCH

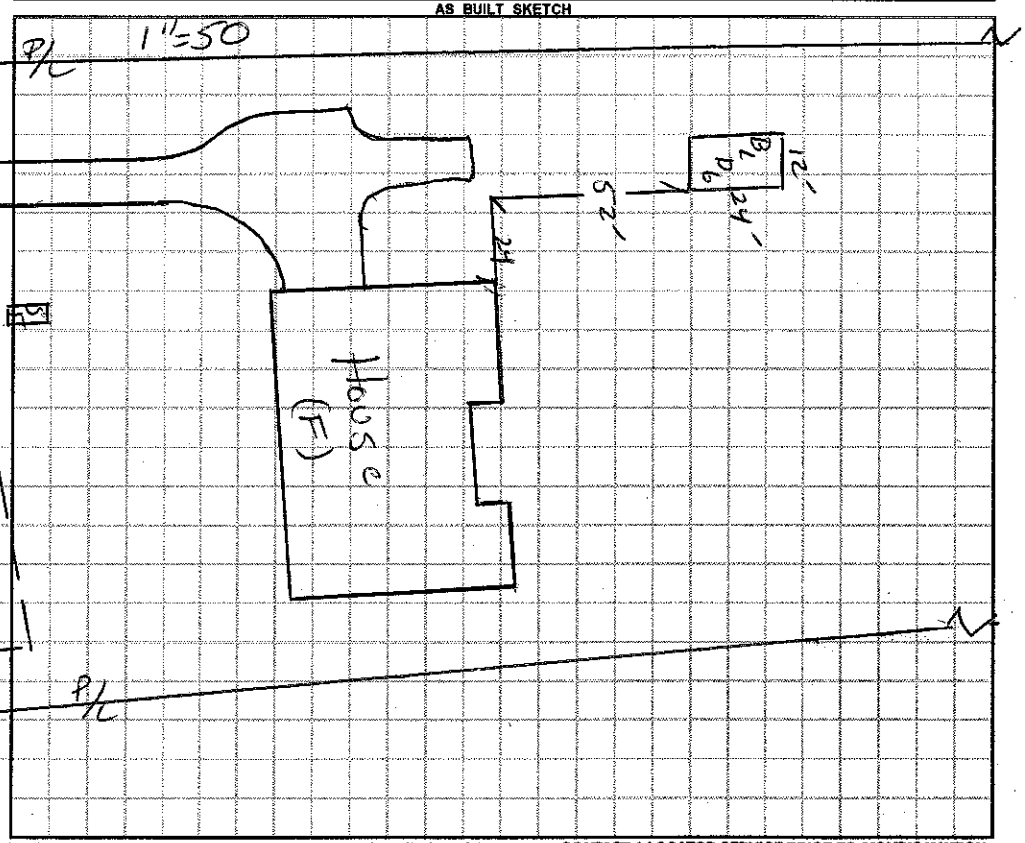

Permit can be suspended or revoked if any false information is supplied toward securing the permit / any unauthorized changes are made to the site / any unauthorized changes are made in the installation of the system. **CONTACT A LOCATOR SERVICE PRIOR TO ANY EXCAVATION**

☐ **IMPROVEMENT PERMIT** *with plat valid without expiration.* ☐ **IMPROVEMENT PERMIT** *with site plan valid for 60 mos.* ☐ **AUTHORIZATION TO CONSTRUCT** *valid for period equal to IMPROVEMENT PERMIT--not to exceed 60 mo.*

Owner / Applicant Signature: Brigid Hess Date: 2/3/15. Installed by:

IMPROVEMENT PERMIT by: Date: OPERATION PERMIT by: Date:

AUTHORIZATION TO CONSTRUCT by: Date: Existing System Inspected by: Date: 02/03/15

Health Dept. Copy - WHITE Applicant (Final Approval) - YELLOW Applicant (Conditional Approval) - PINK

IREDELL COUNTY HEALTH DEPARTMENT

STATESVILLE 704-878-5305 EJ MOORESVILLE 704-664-5281

IMPROVEMENT PERMIT / AUTHORIZATION TO CONSTRUCT / OPERATION PERMIT / EXISTING SYSTEM INSPECTION

PERMIT# 109192 PIN# 4719-84-5490 DATE 10/25/02

OWNER OR CONTRACTOR Bret Rainwater PHONE: Business — Home 704-873-6110

ADDRESS 300 Walnut Tree Road Statesville, N.C. 28625

LOCATION I-40 W, (L) on Stamey Farm Rd, (L) on Gilbert Road, Property on left.

SUBDIVISION PRICE BLOCK / SECTION — LOT 9 LOT AREA 2.74 Ac± SITE CLASS. PS DESIGN FLOW 480 L.T.A.R. .30 gpd/ft²

Septic Tank: 1500 Gallons; STB 1012 Date 2-1-04 — [X] New System [ ] Repair System Type: I (II) III, IV, V, VI — [X] House/Mod. Home No. Bedrooms 4 — Water Supply: [ ] Individual [X] Public [ ] Community

Pump Tank: 1,000 Gallons; PT — Date — System Description: Gravity, Conventional — [ ] Mobile Home No. Bathrooms 3

Pump Make: — Model — Serial No. — Repair System Description: Gravity, 25% Red — [ ] Business No. Employees —


Nitrification Field: No Fields 1 Square Feet 1600 Linear Feet 534 — Maintenance Agreement Required: [ ] Yes [X] No — [ ] Other —

No Lines 5 Trench Width 36" Max Trench Bottom Depth 30" Gravel Depth 12" — [ ] Slab [X] Crawl Space [ ] Basement w/plumbing [ ] Basement wo/plumbing


Comments:/Conditions: (1) Install lines on Contour (2) Maintain Proper Setbacks (3) Install Subsurface (French) Drain as shown 48" Deep to daylight (4) Install 2nd Tank for basement plumbing only

Comments:/Conditions: Crawl Space House, No Basement, (1) only S.T. needed. ins 12/3/03 — Tarp - Tank Filter & S.T. marker Installed

INITIAL SITE SKETCH (Not to Scale)

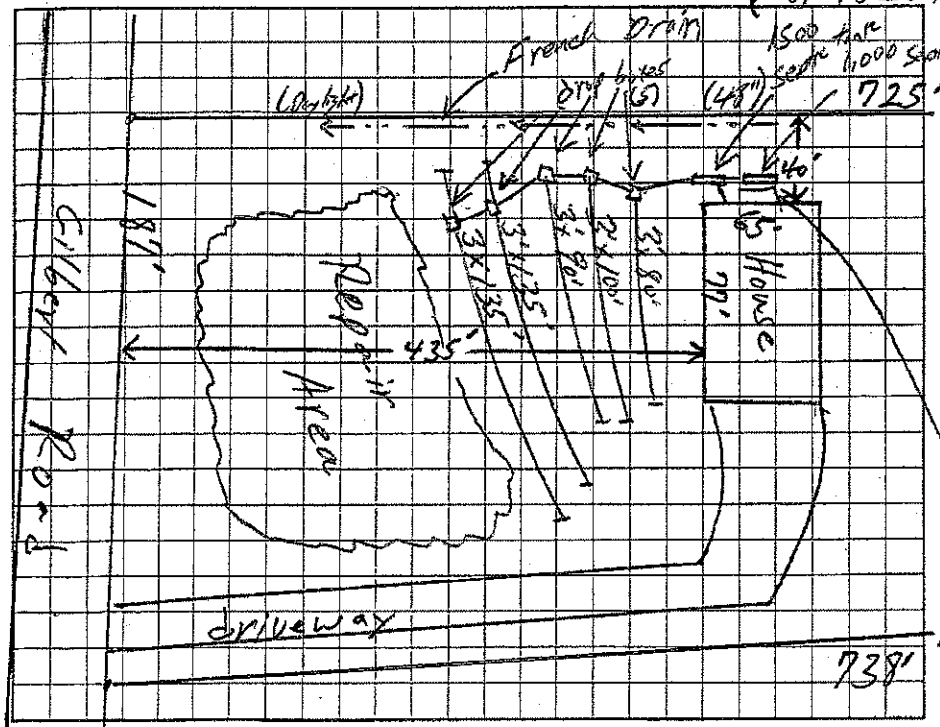

AS BUILT SKETCH (Not To Scale)

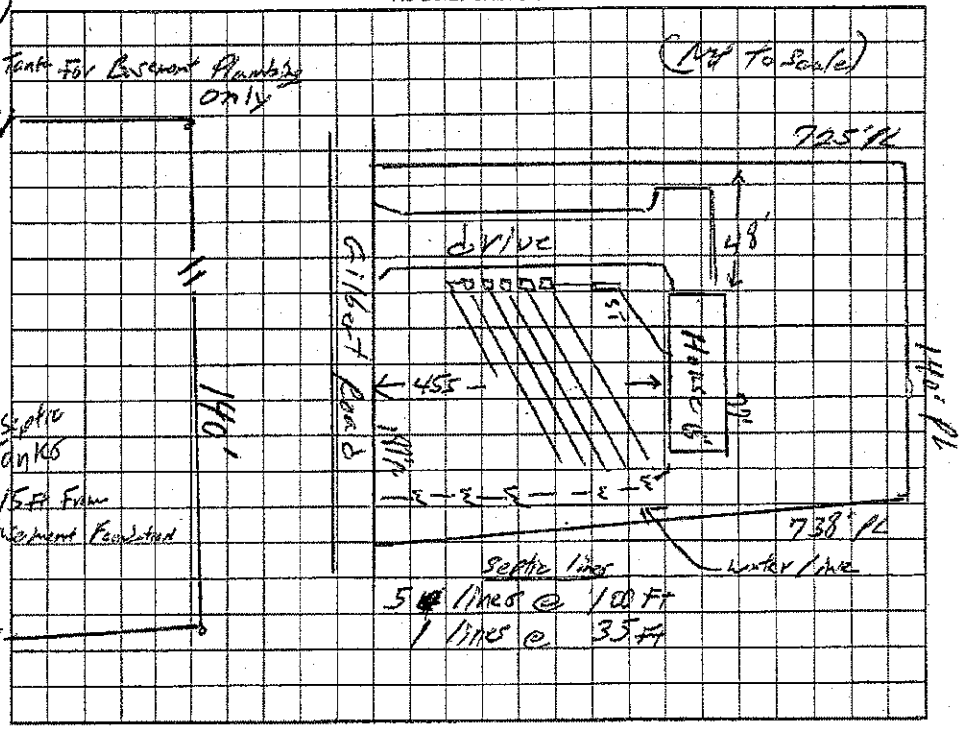

Permit can be suspended or revoked if any false information is supplied toward securing the permit/any unauthorized changes are made to the site/any unauthorized changes are made in the installation of the system. Improvement Permit with plat valid without expiration. Improvement Permit with site plan valid for sixty months. Authorization to Construct is valid for a period equal to that of Improvement Permit – not to exceed sixty months.

Signed: Bret Rainwater date 11/1/02 Installed by: Steve Jordan

Improvement Permit by: William O. Johnson date 10/30/02 Operation Permit by: William O. Johnson date 6/30/04

Authorization to Construct by: William O. Johnson date 12/3/03 Existing System Inspection by: — date —

HEALTH DEPT. COPY: WHITE OWNER COPY (FINAL): YELLOW OWNER COPY (INITIAL): PINK