IREDELL COUNTY HEALTH DEPARTMENT

Statesville Phone TR 3-7271 Mooresville Phone NO 3-1271

PERMIT TO INSTALL SEPTIC TANK

Permit No. 183 Permit Date 4 June 1970

Owner Benny Daniels Address Statesville, NC.

Installed By Lackey Bros. Address Stony Point, NC


Location of Property Highway 90 to Road #1006 to Left pass Third Creek Bridge (Island Ford Park) House on left.

Tank		Capacity		Length of Lines		Fixtures	
Block	( )	1000	(✓)	225'	(✓)	No. of Baths	(1½
Precast	(✓)	1250	( )	250'	( )	Dishwasher	( )
		1500	( )	Other		Garbage Grdr.	( )
		Other				Other	

NOTIFY HEALTH DEPARTMENT AT LEAST EIGHT HOURS BEFORE TANK IS TO BE INSPECTED.

Final Inspection 4 June 1970 Approved (✓) Disapproved ( )

Remarks Central Water Supply

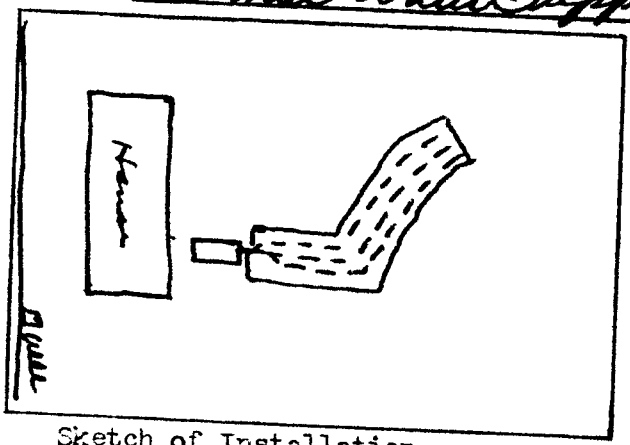

Sketch of Installation

Glenn Foard Jr.

Sanitarian