IREDELL COUNTY HEALTH DEPARTMENT

Statesville Phone TR 3-7271 Mooresville Phone NO 3-1271

PERMIT TO INSTALL SEPTIC TANK

Permit NO. 330 Permit Date SEPT 24 1970

Owner BENNY DANIELS Address STATESVILLE NC

Installed By LACKEY BROS Address STONY POINT N.C.


Location of Property ISLAND FORD PARK - 1ST BRICK HOUSE ON LEFT.

| Tank | | Capacity | | Length of Lines | | Fixtures | |
|---|---|---|---|---|---|---|---|
| Block | ( ) | 1000 | (✓) | 225' | (✓) | No. of Baths | (2) |
| Precast | (✓) | 1250 | ( ) | 250' | ( ) | Dishwasher | ( ) |
| | | 1500 | ( ) | Other | | Garbage Grdr. | ( ) |
| | | Other | | | | Other | |

NOTIFY HEALTH DEPARTMENT AT LEAST EIGHT HOURS BEFORE TANK IS TO BE INSPECTED.

Final Inspection SEPT. 24 1970 Approved (✓) Disapproved ( )

Remarks CENTRAL WATER SYSTEM

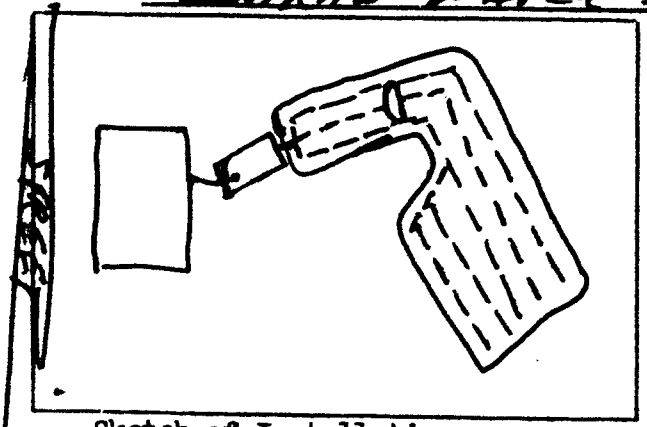


Sketch of Installation

Sanitarian