IREDELL COUNTY HEALTH DEPARTMENT

STATESVILLE 704-878-5305 MOORESVILLE 704-664-5281

IMPROVEMENT PERMIT / CERTIFICATE OF COMPLETION / OPERATION PERMIT / EXISTING SYSTEM INSPECTION

PROPERTY DESCRIPTION NO. Repair DATE 8-25-97 TAX MAP NO. Repair Watershed: ☐ Yes ☐ No

OWNER OR CONTRACTOR Ken Dishman PHONE: Business _____ Home _____

ADDRESS 617 Island Ford Rd Statesville

LOCATION 904 Ft Island Ford cross Third Creek 3rd House on left

SUBDIVISION _____ BLOCK / SECTION _____ LOT _____ LOT AREA _____ SITE CLASS. _____ DESIGN FLOW 360 L.T.A.R. _____

Septic Tank: 1000 Gallons; STB _____ Date _____

Pump Tank: _____ Gallons; PT _____ Date _____

Pump Make: _____ Model _____ Serial No. _____

Nitrification Field: No Fields 2 Square Feet _____ Linear Feet _____

No Lines 2 Trench Width 36in Max Trench Bottom Depth 5

☐ New System ☒ Repair System Type: I, II, III, IV, V, VI

System Description: _____

Repair System Description: Gravity Conventional

Maintenance Agreement Required: ☐ Yes ☐ No

Gravel Depth 18in ☐ Slab ☒ Crawl Space ☐ Basement w/plumbing ☐ Basement wo/plumbing

☒ House/Mod. Home No. Bedrooms 3

☐ Mobile Home No. Bathrooms 1 1/2

☐ Business No. Employees _____

☐ Other _____


Water Supply: ☒ Individual ☐ Community ☒ Public

Comments:


Keep lines on Contour
Tie back into old Line past Tree

Comments:

INITIAL SITE SKETCH

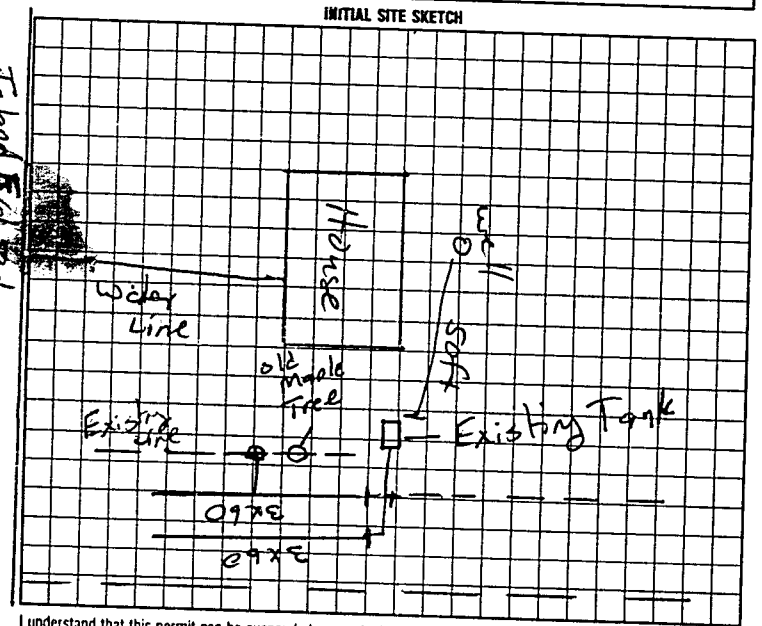

AS BUILT SKETCH

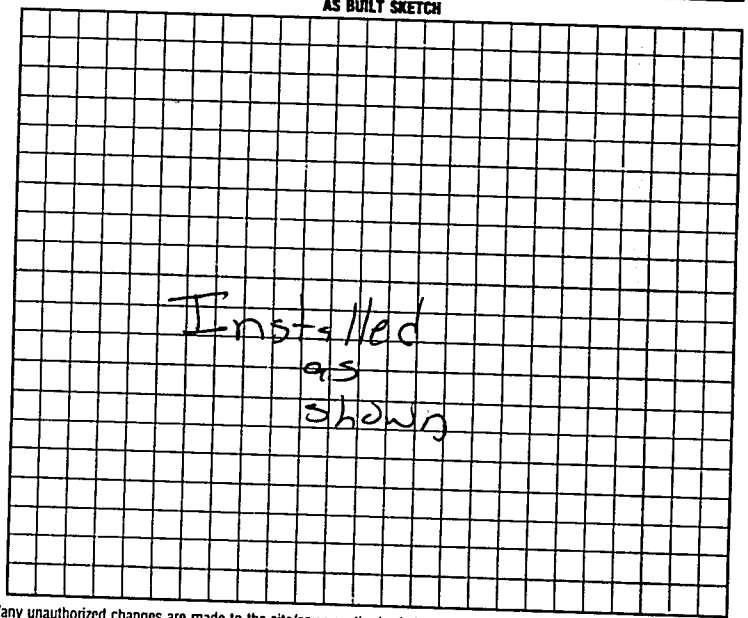

I understand that this permit can be suspended or revoked if any false information is supplied toward securing the permit/any unauthorized changes are made to the site/any unauthorized changes are made in the installation of the system. Improvement Permit is valid for 60 months from date of issuance.

Signed: Ken Dishman

Improvement Permit by: Mark C Ort RS date 8-25-97

Authorization to Existing System Inspection by: Mark C Ort RS date 8-25-97 Const

Installed by: Donald Lackey

Certificate of Completion by: _____ date _____

Operation Permit by: Mark C Ort RS date 8-26-97

HEALTH DEPT. COPY: WHITE INSPECTION COPY (FINAL): GREEN OWNER COPY (FINAL): YELLOW INSPECTION COPY (INITIAL): PINK OWNER COPY (INITIAL): GOLD