IREDELL COUNTY HEALTH DEPARTMENT

Statesville Phone TR 3-7271 Mooresville Phone NO 3-1271

PERMIT TO INSTALL SEPTIC TANK

Permit No. 1 Permit Date Sept. 26 1970

Owner Robert Brawley Address Island Ford Park

Installed By Lackey Bros. Co. Address Stony Point N.C.


Location of Property First house on Right in Island Ford Park

Tank		Capacity		Length of Lines		Fixtures	
Block	( )	1000	( )	225'	( )	No. of Baths	(1½)
Precast	(✓)	1250	( )	250'	(✓)	Dishwasher	( )
		1500	( )	Other		Garbage Grdr.	( )
		Other				Other	

NOTIFY HEALTH DEPARTMENT AT LEAST EIGHT HOURS BEFORE TANK IS TO BE INSPECTED.

Final Inspection 19__ Approved ( ) Disapproved ( )

Remarks (No well)

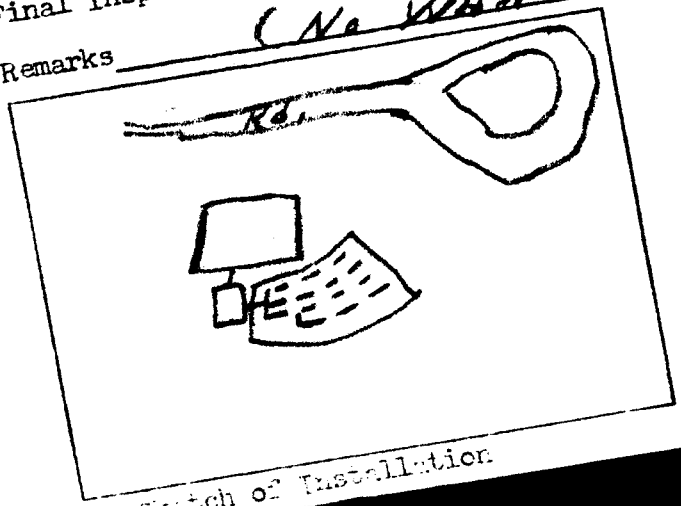

Sketch of Installation

Sanitarian