48037

IREDELL COUNTY HEALTH DEPARTMENT

STATESVILLE 704-878-5305 MOORESVILLE 704-664-5281

IMPROVEMENT PERMIT / CERTIFICATE OF COMPLETION / OPERATION PERMIT / EXISTING SYSTEM INSPECTION

PROPERTY DESCRIPTION NO. 16187 DATE 4-4-94 TAX MAP NO. 8K-3-B-102 Watershed: ☐ Yes ☑ No

OWNER OR CONTRACTOR Edward F. Moore PHONE: Business 1-800-922-3795 Home

ADDRESS

LOCATION I40W Tl Stamey Farm Rd Tl Ashebrook Rd 1st on R across from Karmen Lane.

SUBDIVISION NA BLOCK / SECTION LOT 102-117 LOT AREA 3.63 Acres SITE CLASS. P.S. DESIGN FLOW 360 L.T.A.R. .35 gpd/ft²

Septic Tank: 1000 Gallons; STB 782 Date 1-14-94

Pump Tank: — Gallons; PT — Date —

Pump Make: — Model — Serial No. —

Nitrification Field: No Fields 1 Square Feet 1035 Linear Feet 345'

No Lines 3 Trench Width 36" Max Trench Bottom Depth 8'-36" Gravel Depth 12"

☑ New System ☐ Repair System Type: I, II, III, IV, V, VI

System Description: Conventional, gravity

Repair System Description: pump to conventional

Maintenance Agreement Required: ☐ Yes ☑ No

☑ House/Mod. Home ☐ Mobile Home ☐ Business ☐ Other

No. Bedrooms 3 No. Bathrooms 3.5 No. Employees

☐ Slab ☐ Crawl Space ☑ Basement w/plumbing ☐ Basement wo/plumbing


Water Supply: ☐ Individual ☐ Community ☑ Public

Comments:

Comments: Home place further back on lot than what was permitted. 142' instead of 122' off Rd. This caused repair Area to be moved across head slope on Rear of lot. (pump to Repair) Partial Repair Area below drainlines.

INITIAL SITE SKETCH

AS BUILT SKETCH

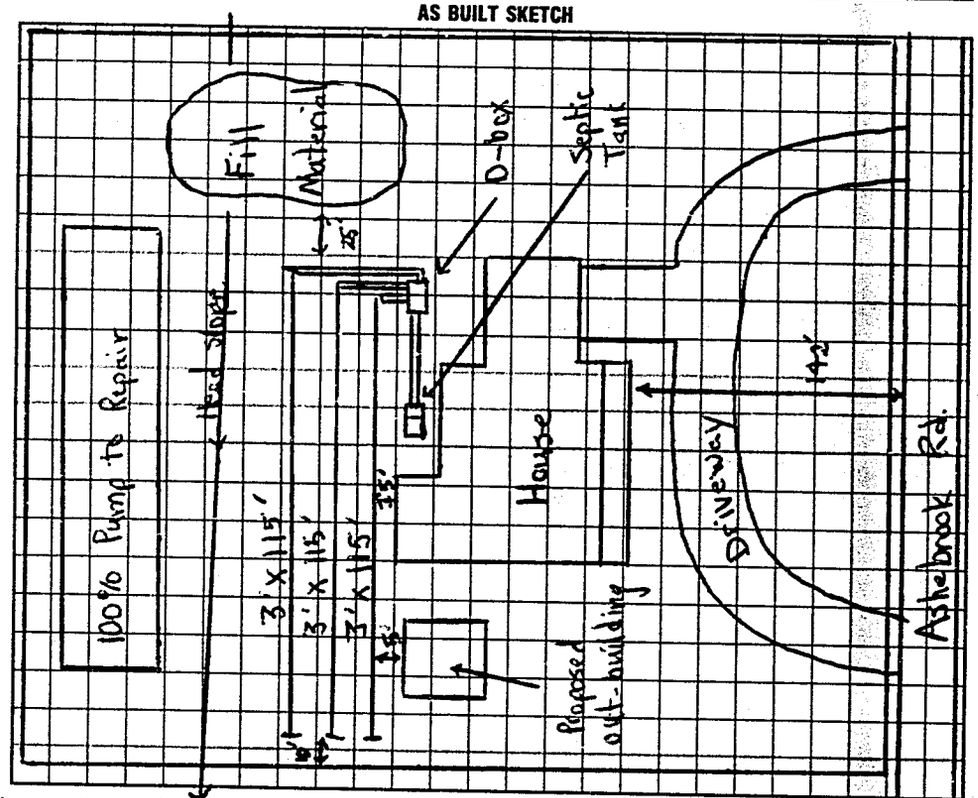

I understand that this permit can be suspended or revoked if any false information is supplied toward securing the permit/any unauthorized changes are made to the site/any unauthorized changes are made in the installation of the system. Improvement Permit is valid for 60 months from date of issuance.

Signed:

Improvement Permit by: Michael J. Dennis date 4-22-93

Existing System Inspection by: date

Installed by: John Huffman.

Certificate of Completion by: Michael J. Dennis date 4-4-94

Operation Permit by: date

HEALTH DEPT. COPY: WHITE INSPECTION COPY (FINAL): GREEN OWNER COPY (FINAL): YELLOW INSPECTION COPY (INITIAL): PINK OWNER COPY (INITIAL): GOLD