IREDELL COUNTY HEALTH DEPARTMENT

STATESVILLE 704-878-5305 MOORESVILLE 704-664-5281

IMPROVEMENT PERMIT / CERTIFICATE OF COMPLETION / OPERATION PERMIT / EXISTING SYSTEM INSPECTION

PROPERTY DESCRIPTION NO. ~~[illegible]~~ 063593 DATE 10-15-96 TAX MAP NO. 8K-11-A-7 Watershed: ☐ Yes ☒ No

OWNER OR CONTRACTOR Sun Wood Bldg PHONE: Business _____ Home 872-0921

ADDRESS PO Box 5877 Statesville NC 28687

LOCATION 30W TR Ashbrook TR Karmen Lane End of Cul De Sac

SUBDIVISION Piney Brook BLOCK / SECTION _____ LOT 7 LOT AREA 1 3/4 ac. SITE CLASS. P/S DESIGN FLOW 360 L.T.A.R. 0.3

Septic Tank: 1000 Gallons; STB 1012 Date 3-14-97

Pump Tank: _____ Gallons; PT _____ Date _____

Pump Make: _____ Model _____ Serial No. _____

Nitrification Field: No Fields 1 Square Feet 900 Linear Feet 300

No Lines 2 Trench Width 36in Max Trench Bottom Depth 36in Gravel Depth _____

☒ New System ☐ Repair System Type: I, II, III, IV, V, VI

System Description: Chamber gravity

Repair System Description: Chamber gravity

Maintenance Agreement Required: ☐ Yes ☒ No

☒ House/Mod. Home No. Bedrooms 3

☐ Mobile Home No. Bathrooms 2 1/2

☐ Business No. Employees _____

☐ Other _____


☐ Slab ☐ Crawl Space ☒ Basement w/plumbing ☐ Basement wo/plumbing

Water Supply: ☐ Individual ☐ Community ☒ Public


Comments: keep lines on contour, 9ft on center use Chambers

Comments:

INITIAL SITE SKETCH

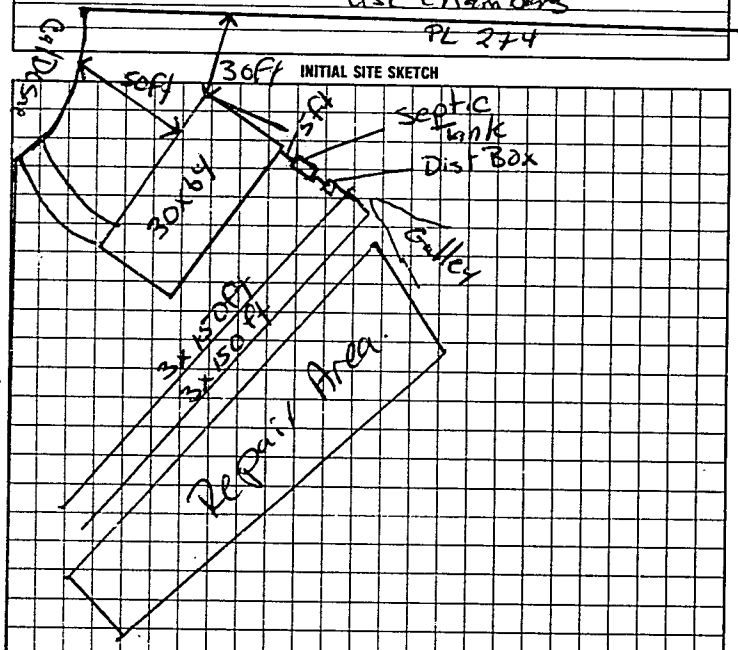

AS BUILT SKETCH

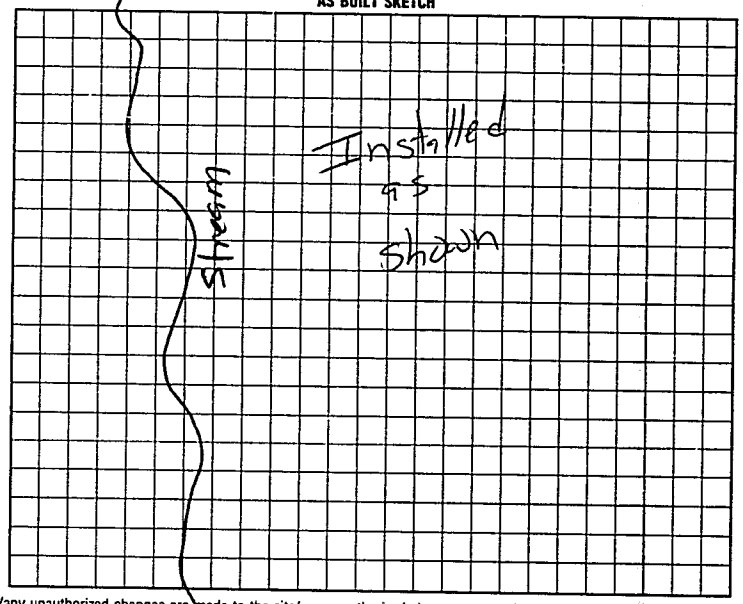

I understand that this permit can be suspended or revoked if any false information is supplied toward securing the permit/any unauthorized changes are made to the site/any unauthorized changes are made in the installation of the system.

Authorization to construct expires 5 yrs after issue

Signed: _____

Improvement Permit by: Authorization to Const Mark Cox RS date 10-15-96

Existing System Inspection by: Mark Cox RS date 10-15-96

Installed by: Tommy Frye

Certificate of Completion by: _____ date _____

Operation Permit by: Mark Cox RS date 5-13-97

HEALTH DEPT. COPY: WHITE INSPECTION COPY (FINAL): GREEN PL 321 OWNER COPY (FINAL): YELLOW INSPECTION COPY (INITIAL): PINK OWNER COPY (INITIAL): GOLD

321