IREDELL COUNTY HEALTH DEPARTMENT

STATESVILLE 704-878-5305 MOORESVILLE 704-664-5281

IMPROVEMENT PERMIT / AUTHORIZATION TO CONSTRUCT / OPERATION PERMIT / EXISTING SYSTEM INSPECTION

PERMIT# Repair PIN# 4714927092 DATE 7-11-08

OWNER OR APPLICANT Jill Schooley PHONE: Business 704 872 4400 Home 304 914 1047

ADDRESS 220 Jamie Dr.

LOCATION I-40 West Exit 148 (TL) 64/90 (TR) Hwy 70 (TR) Ashbrook (TR) Jamie Dr. - At end of Rd.

SUBDIVISION Ashbrook BLOCK / SECTION LOT 20 LOT AREA Ex SITE CLASS. Ex DESIGN FLOW Ex L.T.A.R. Ex

Septic Tank: 1000 Gallons; STB 1007 Date 5-11-08
Pump Tank: Gallons; PT Date
Pump Make: Model Serial No.
Nitrification Field: No Fields Ex Square Feet Ex Linear Feet Ex
No Lines Ex Trench Width Max Trench Bottom Depth Gravel Depth

☐ New System ☑ Repair ☐ Expansion System Type: I (II) III IV V VI
System Description: Existing
Repair System Description: Existing
Maintenance Agreement Required: ☐ Yes ☐ No

☑ House/Mod. Home No. Bedrooms 3
☐ Mobile Home No. Persons
☐ Business No. Employees
☐ Other


Water Supply: ☐ Individual ☑ Public ☐ Community

☑ Gravity ☐ Pressure ☐ Slab ☐ Crawl Space ☐ Basement w/plumbing ☑ Basement wo/plumbing

Comments:/Conditions:

Comments:/Conditions:

INITIAL SITE SKETCH

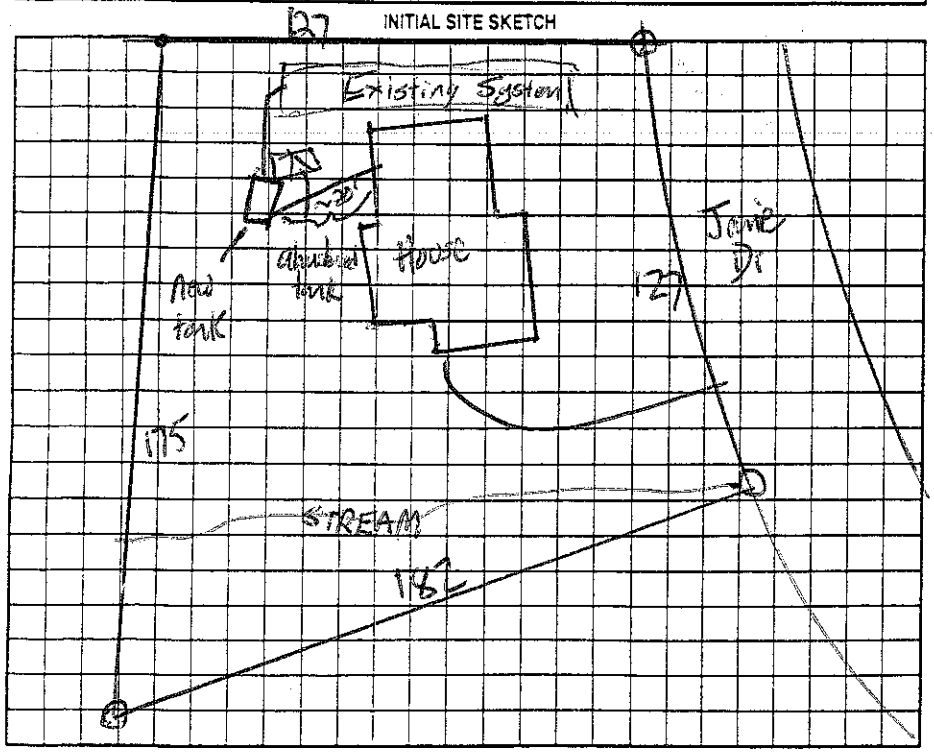

AS BUILT SKETCH

Permit can be suspended or revoked if any false information is supplied toward securing the permit/any unauthorized changes are made to the site/any unauthorized changes are made in the installation of the system. Improvement Permit with plat valid without expiration ☐ Improvement Permit with site plan valid for sixty months ☐ Authorization to Construct is valid for a period equal to that of Improvement Permit – not to exceed sixty months.

Signed: date

Improvement Permit by: date

Authorization to Construct by: date

Installed by: K & M Grading

Operation Permit by: James Dean date 7-11-08

Existing System Inspection by: date

HEALTH DEPT. COPY: WHITE OWNER COPY (FINAL): YELLOW OWNER COPY (INITIAL): PINK