IREDELL COUNTY HEALTH DEPARTMENT

STATESVILLE 704-878-5305 MOORESVILLE 704-664-5281

IMPROVEMENT PERMIT / CERTIFICATE OF COMPLETION / OPERATION PERMIT / EXISTING SYSTEM INSPECTION

PROPERTY DESCRIPTION NO. Repair DATE 7-7-93 PHONE: Business _____ Home 872-3795 TAX MAP NO. Repair

OWNER OR CONTRACTOR John George

ADDRESS Rt 3 Box 64A Jamie Rd. Statesville, N.C., 28677

LOCATION I40W TL Stamey Farm Rd. TL Ashbrook Rd. TR Jamie Rd. 2nd house on R.

SUBDIVISION Ashbrook Park BLOCK / SECTION _____ LOT 20 LOT AREA 20,000 sqft. SITE CLASS. Repair L.T.A.R. Repair

Water Supply: ☐ Individual ☐ Community ☑ Public County water

Septic Tank: — Gallons: STB — Date —

Pump Tank: — Gallons: PT — Date —

Nitrification Field: No Fields 1 Square Feet 150 Linear Feet 50'

No Lines 1 Trench Width 36" Trench Depth 36" Gravel Depth 18"

☐ New System ☑ Repair System Type: I. II. IV. V. VI

System Description: Conventional, gravity

Repair System Description: _____

Maintenance Agreement Required: ☐ Yes ☐ No

☑ House/Mod. Home ☐ Mobile Home ☐ Business ☐ Other _____

No. Bedrooms 3 No. Bathrooms 2 No. Employees —

☐ Slab ☑ Crawl Space ☐ Basement w/plumbing

Garbage Disposal: ☐ Yes ☑ No

Auto. Dishwasher: ☐ Yes ☐ No


Auto. Washing Machine: ☑ Yes ☐ No

Other _____ ☐ Basement wo/plumbing

Comments Washing machine drain line. Fed old line first, Repair lin last.

INITIAL SITE SKETCH

AS BUILT SKETCH

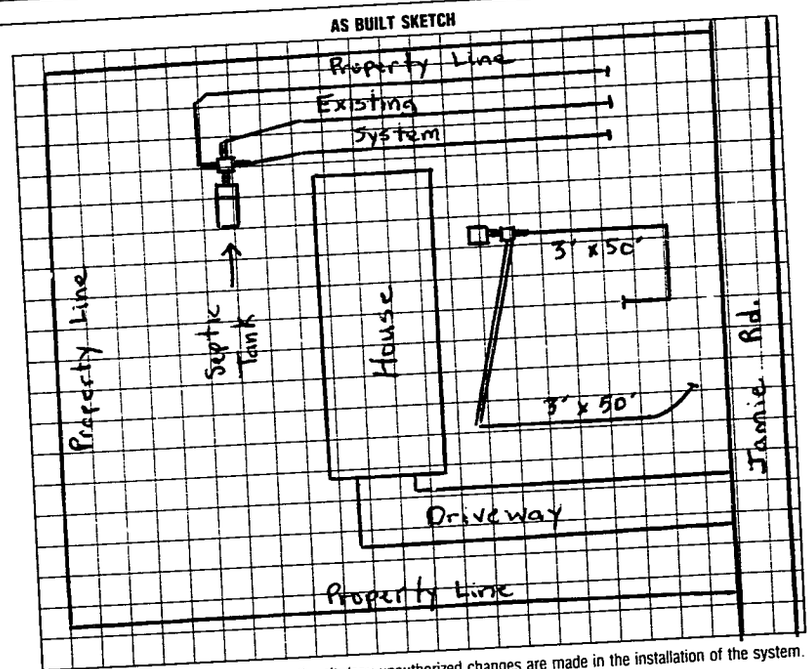

I understand that this permit can be suspended or revoked if any false information is supplied toward securing the permit/any unauthorized changes are made to the site/any unauthorized changes are made in the installation of the system. Improvement Permit is valid for 60 months from date of issuance.

Signed: _____

Improvement Permit by: Michael J. Dennis date 5-20-93

Existing System Inspection by: _____ date _____

Installed by: Eddie Younts and Sons

Certificate of Completion by: Michael J. Dennis date 7-7-93

Operation Permit by: _____ date _____

HEALTH DEPT. COPY: WHITE INSPECTION COPY (FINAL): GREEN OWNER COPY (FINAL): YELLOW INSPECTION COPY (INITIAL). PINK OWNER COPY (INITIAL): GOLD