IREDELL COUNTY HEALTH DEPARTMENT

STATESVILLE 704-878-5305 MOORESVILLE 704-664-5281

IMPROVEMENT PERMIT / AUTHORIZATION TO CONSTRUCT / OPERATION PERMIT / EXISTING SYSTEM INSPECTION

PERMIT# 90399 PIN# 4714932613 DATE 7-11-00

OWNER OR CONTRACTOR Cindy Atkins PHONE: Business 924 8256 Home

ADDRESS PO Box 5848 Statesville, N.C.

LOCATION 70W TR Gilbert Rd on left past Pontasyrie Lane (255 Gilbert Rd)

SUBDIVISION BLOCK / SECTION LOT LOT AREA 3.32 acres SITE CLASS PS DESIGN FLOW 360 L.T.A.R. .3

Septic Tank: 1000 Gallons; STB 794 Date 7-17

Pump Tank: Gallons; PT Date

Pump Make: Model Serial No.

Nitrification Field: No Fields 1 Square Feet 1200 Linear Feet 400

No Lines 3 Trench Width 36" Max Trench Bottom Depth 36" Gravel Depth 12"

☑ New System ☐ Repair System Type: I II III IV V VI

System Description: Conv. Gravity

Repair System Description: Pump To Conventional

Maintenance Agreement Required: ☐ Yes ☑ No

☑ House/Mod. Home ☐ Mobile Home ☐ Business ☐ Other

No. Bedrooms 3 No. Bathrooms 2 No. Employees


Water Supply: ☑ Individual ☐ Public ☐ Community

☐ Slab ☐ Crawl Space ☑ Basement w/plumbing ☐ Basement wo/plumbing


Comments/Conditions:

Comments/Conditions: Installed as shown

INITIAL SITE SKETCH

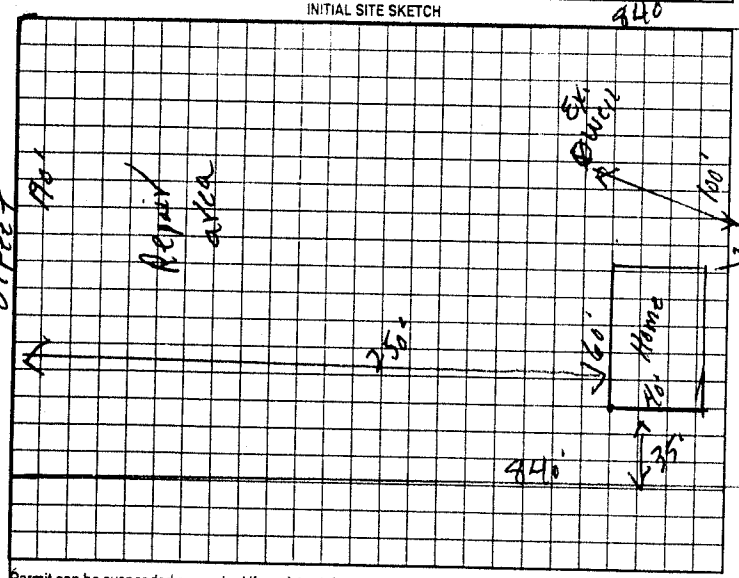

AS BUILT SKETCH

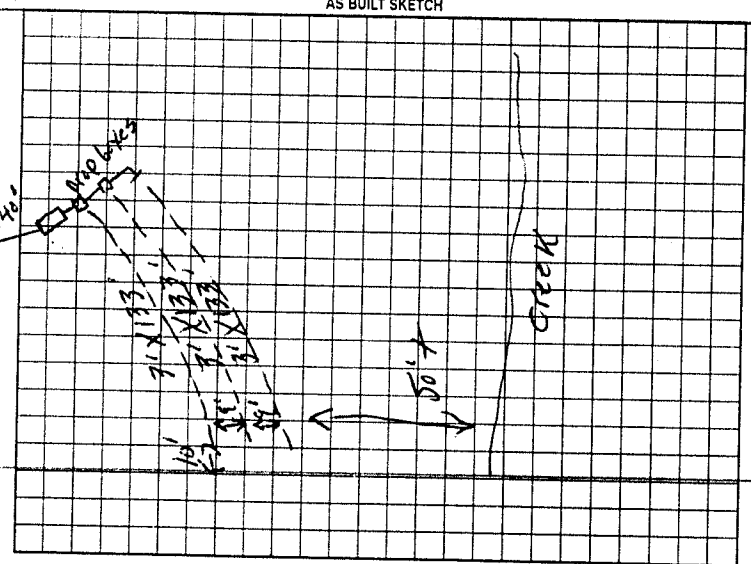

Permit can be suspended or revoked if any false information is supplied toward securing the permit/any unauthorized changes are made to the site/any unauthorized changes are made in the installation of the system. Improvement Permit with plat valid without expiration. Improvement Permit with site plan valid for sixty months. Authorization to Construct is valid for a period equal to that of Improvement Permit – not to exceed sixty months.

Signed: X Cindy Atkins date

Improvement Permit by: P.C. Moore date 7-11-00

Authorization to Construct by: P.C. Moore date 7-11-00

Installed by: Wes Lytton

Operation Permit by: Mary C. Ostby date 8-22-00

Existing System Inspection by: date

HEALTH DEPT. COPY: WHITE OWNER COPY (FINAL) YELLOW OWNER COPY (INITIAL) PINK