IREDELL COUNTY HEALTH DEPARTMENT

S" ..SVILLE 704-878-5305 155.00 Paid CI MOORESVILLE 704-664-5281

IMPROVEMENT PERMIT / AUTHORIZATION TO CONSTRUCT / OPERATION PERMIT / EXISTING SYSTEM INSPECTION

PERMIT# 104565 PIN# 4715070370 DATE 3/13/02

OWNER OR CONTRACTOR STONES EDGE INC PHONE: Business 663-2220 Home

ADDRESS 130 LAZY LANE MOORESVILLE NC 28117

LOCATION 64W- TL LIPPARD FARM- TL STONES EDGE - TL OAKSTONE - TR ZERCON - FL TITANIUM - ON RT

SUBDIVISION STONES EDGE BLOCK / SECTION LOT 72 LOT AREA 1.55AC SITE CLASS PS DESIGN FLOW 360GPD L.T.A.R. .36/.27

Septic Tank: 1000 Gallons: STB 1012 Date 12-08-01
Pump Tank: Gallons: PT Date
Pump Make: Model Serial No
Nitrification Field: No Fields 1 Square Feet 900 Linear Feet 300
No Lines 4@75' Trench Width 36" Max Trench Bottom Depth 36" Gravel Depth NA

☑ New System ☐ Repair System Type: I. II (III) IV. V. VI
System Description: GRAVITY 25% REDUCTION
Repair System Description: PUMP SAME
Maintenance Agreement Required: ☐ Yes ☑ No

☑ House/Mod Home ☐ Mobile Home ☐ Business ☐ Other
No. Bedrooms 3 No. Bathrooms 3 No. Employees


☐ Slab ☑ Crawl Space ☐ Basement w/plumbing ☐ Basement wo/plumbing

Water Supply: ☐ Individual ☑ Public ☐ Community

Comments:/Conditions:

Comments /Conditions POLYLOK & MARKER

INITIAL SITE SKETCH 1"=50'

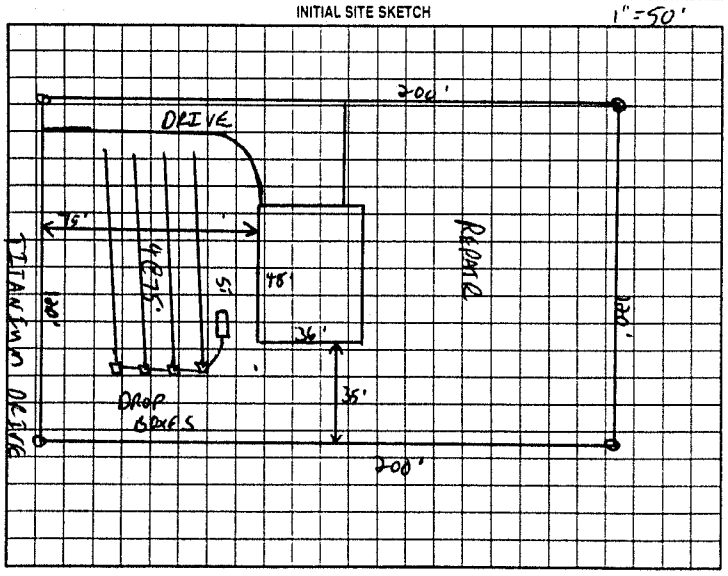

AS BUILT SKETCH

Permit can be suspended or revoked if any false information is supplied toward securing the permit/any unauthorized changes are made to the site any unauthorized changes are made in the installation of the system. Improvement Permit with plat valid without expiration. Improvement Permit with site plan valid for sixty months. Authorization to Construct is valid for a period equal to that of Improvement Permit – not to exceed sixty months

Signed: Dennis Dollar date 4-30-02 Installed by: A-1 BACKHOE

Improvement Permit by: C. Yates RS date 3/13/02 Operation Permit by: [signature] RS date 05-01-02

Authorization to Construct by: C. Yates RS date 3/13/02 Existing System Inspection by: date

HEALTH DEPT COPY: WHITE OWNER COPY (FINAL): YELLOW OWNER COPY (INITIAL): PINK