IREDELL COUNTY HEALTH DEPARTMENT

STATESVILLE 704-878-5305 MOORESVILLE 704-664-5281

IMPROVEMENT PERMIT / AUTHORIZATION TO CONSTRUCT / OPERATION PERMIT / EXISTING SYSTEM INSPECTION

PERMIT# 102631 PIN# 4705 85 8934 . 71 DATE 10/24/01

OWNER OR CONTRACTOR JOHN CRAVER PHONE: Business 663-2220 Home

ADDRESS 130 LAZY LN MOORESVILLE NC 28117

LOCATION 64W- TL LIPPARD FARM - TL STONES EDGE - TL GEMSTONE - TR TITANIUM AT END OF LS

SUBDIVISION STONES EDGE BLOCK / SECTION LOT 71 LOT AREA .818 AC SITE CLASS PS DESIGN FLOW 360GD L.T.A.R. 360GD/LF

Septic Tank: 1000 Gallons: STB 354 Date 6-12-01
Pump Tank: Gallons: PT Date
Pump Make: Model Serial No.
Nitrification Field: No Fields 1 Square Feet 1200 Linear Feet 400
No Lines 5@80' Trench Width 36" Max Trench Bottom Depth 36" Gravel Depth 12"

☑ New System ☐ Repair System Type: I (II) III, IV, V, VI
System Description: GRAVITY CONVENTIONAL
Repair System Description: SAME PUMP/GRAV.
Maintenance Agreement Required: ☐ Yes ☑ No


☑ House/Mod. Home No. Bedrooms 3
☐ Mobile Home No. Bathrooms 3
☐ Business No. Employees
☐ Other
☐ Slab ☑ Crawl Space ☐ Basement w/plumbing ☐ Basement wo/plumbing

Water Supply: ☐ Individual ☑ Public ☐ Community


Comments/Conditions: Client is place a 28x48 MH in same location 100' from rear of property. Septic installation will not change

Comments/Conditions: - Poly-lok Filter Installed - Septic Tank Marker Installed

INITIAL SITE SKETCH 1" = 50'

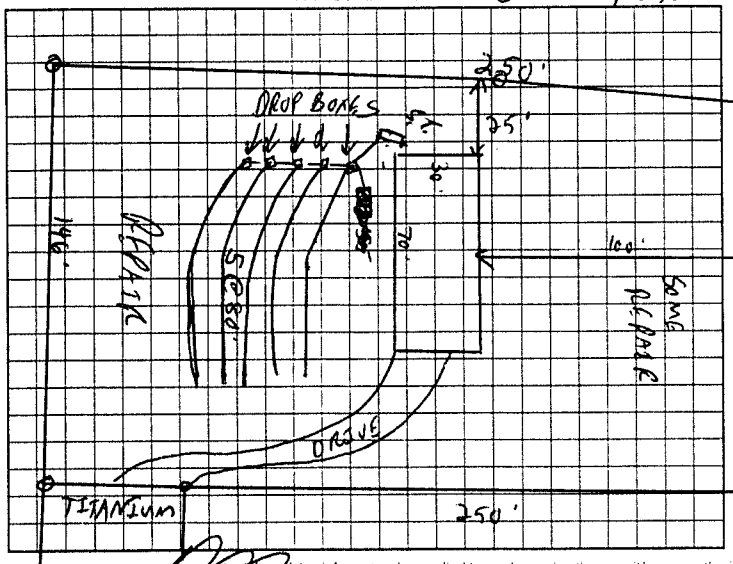

AS BUILT SKETCH

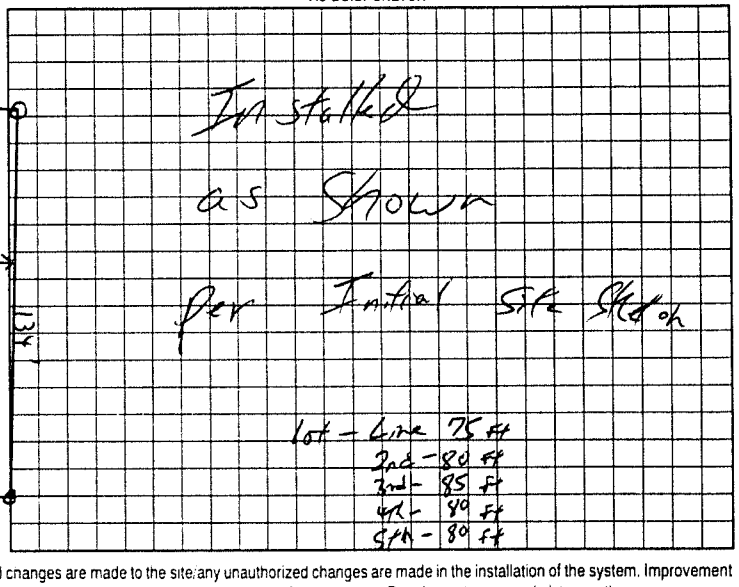

Permit can be suspended or revoked if any false information is supplied toward securing the permit/any unauthorized changes are made to the site/any unauthorized changes are made in the installation of the system. Improvement Permit with plat valid without expiration. Improvement Permit with site plan valid for sixty months. Authorization to Construct is valid for a period equal to that of Improvement Permit – not to exceed sixty months.

Signed: 11-2-01 date 11-02-01 Installed by: G+M Enterprise

Improvement Permit by: R.S date 10/24/01 Operation Permit by: William O. Johnson date 1/29/01

Authorization to Construct by: date 11/10/01 Existing System Inspection by: date

HEALTH DEPT COPY WHITE OWNER COPY (FINAL) YELLOW OWNER COPY (INITIAL) PINK