IREDELL COUNTY HEALTH DEPARTMENT

STATESVILLE 704-878-5305 CI MOORESVILLE 704-664-5281

IMPROVEMENT PERMIT / AUTHORIZATION TO CONSTRUCT / OPERATION PERMIT / EXISTING SYSTEM INSPECTION

PERMIT# 091582 PIN# ~~4705488127~~ (A) 4715-070901 876-8600 DATE October 9, 2000

OWNER OR CONTRACTOR Allied Partners PHONE: Business ~~891-1536~~ Home

ADDRESS 310 Treebank Rd. Statesville

LOCATION 90 West TL just past Griffin HVAC onto Village Pt. Drive on left 4th lot past Bridge Mill Ct.

SUBDIVISION Village Point BLOCK / SECTION LOT 2 LOT AREA .592ac SITE CLASS. 05 DESIGN FLOW 360gpd L.T.A.R. .25-.3

Septic Tank: 1000 Gallons; STB 1012 Date 4-23-04

Pump Tank: Gallons; PT Date

Pump Make: Model Serial No.

Nitrification Field: No Fields 1 Square Feet 1410 Linear Feet 470

No Lines 5 Trench Width 36" Max Trench Bottom Depth 36" Gravel Depth 12"

☑ New System ☐ Repair System Type: I, II, III, IV, V, VI

System Description: Conv. conventional

Repair System Description: GRAV pumped ENHANCED

Maintenance Agreement Required: ☐ Yes ☑ No

☑ House/Mod. Home No. Bedrooms 3

☐ Mobile Home No. Bathrooms 2

☐ Business No. Employees

☐ Other

☐ Slab ☑ Crawl Space ☐ Basement w/plumbing ☐ Basement wo/plumbing

Water Supply: ☐ Individual ☑ Public ☐ Community


Comments:/Conditions: Divert stormwater down side property line

Comments:/Conditions:

- Twss - Tile Filter + ST marker
- 1st 4 lines Okay 8/25/04
- 5th Line Okay 8/26/04

1"=50'

INITIAL SITE SKETCH

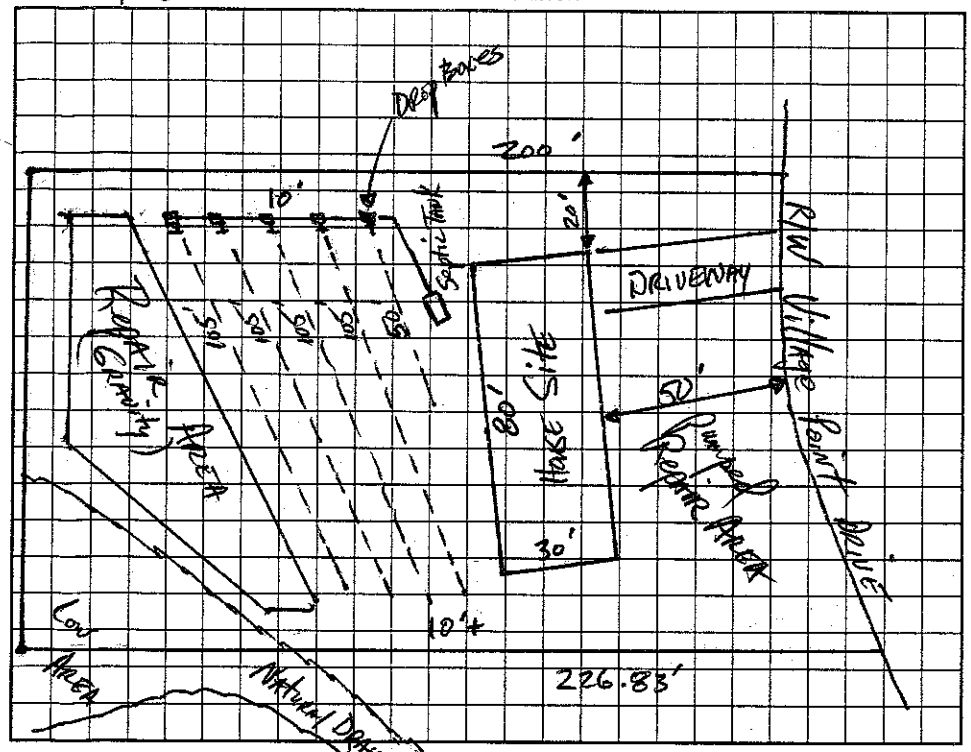

AS BUILT SKETCH

Installed As Shown per Initial Site Sketch

Permit can be suspended or revoked if any false information is supplied toward securing the permit/any unauthorized changes are made to the site/any unauthorized changes are made in the installation of the system. Improvement Permit with plat valid without expiration. Improvement Permit with site plan valid for sixty months. Authorization to Construct is valid for a period equal to that of Improvement Permit – not to exceed sixty months.

Signed: date Installed by: Craig Thompson

Improvement Permit by: date 10-9-00 Operation Permit by: William O. Johnson date 8/26/04

Authorization to Construct by: William O. Johnson date 7/15/04 Existing System Inspection by: date

HEALTH DEPT. COPY: WHITE OWNER COPY (FINAL): YELLOW OWNER COPY (INITIAL): PINK