IREDELL COUNTY HEALTH DEPARTMENT

STATESVILLE 704-878-5305 CI MOORESVILLE 704-664-5281

CI

IMPROVEMENT PERMIT / AUTHORIZATION TO CONSTRUCT / OPERATION PERMIT / EXISTING SYSTEM INSPECTION

PERMIT# 109325 PIN# 4715-07-6921 DATE Nov. 12, 2002

OWNER OR CONTRACTOR Statesville Full Gospel Tabernacle PHONE: Business (704) 500-6607 Home (704) 873-9723

ADDRESS 124 Island Park Lane Statesville N.C. 28625

LOCATION Taylorsville Hwy, @ Village Point Drive on Left.

SUBDIVISION Village Point BLOCK / SECTION — LOT — LOT AREA 6.14 Acres SITE CLASS. P5 DESIGN FLOW 975 L.T.A.R. .33 sq/ft²

Septic Tank: 1640 Gallons; STB See Note Date

Pump Tank: Gallons; PT Date

Pump Make: Model Serial No.

Nitrification Field: No Fields 1 Square Feet 2925 Linear Feet 740

No Lines 11 Trench Width 36" Max Trench Bottom Depth 36" Gravel Depth N/A

☒ New System ☐ Repair System Type: I, II, III, IV, V, VI

System Description: Gravity, [redacted] 25% Reduction

Repair System Description: Gravity Pump Conventional

Maintenance Agreement Required: ☐ Yes ☒ No

☐ House/Mod. Home No. Bedrooms

☐ Mobile Home No. Bathrooms

☐ Business No. Employees

☒ Other Church - 195 members


☒ Slab ☐ Crawl Space ☐ Basement w/plumbing ☐ Basement wo/plumbing

Water Supply: ☐ Individual ☒ Public ☐ Community

Comments/Conditions: ① Do Not Install when wet ② Install lines on contour ③ Do Not Park or drive over Septic Lines ④ ductile iron or equivalent pipe shall be used in areas subject to Vehicular Traffic or 24" of Cover over pipe. 11


Comments/Conditions: HP Approved Okay to move ST to side of House 8/5/03 mf

INITIAL SITE SKETCH

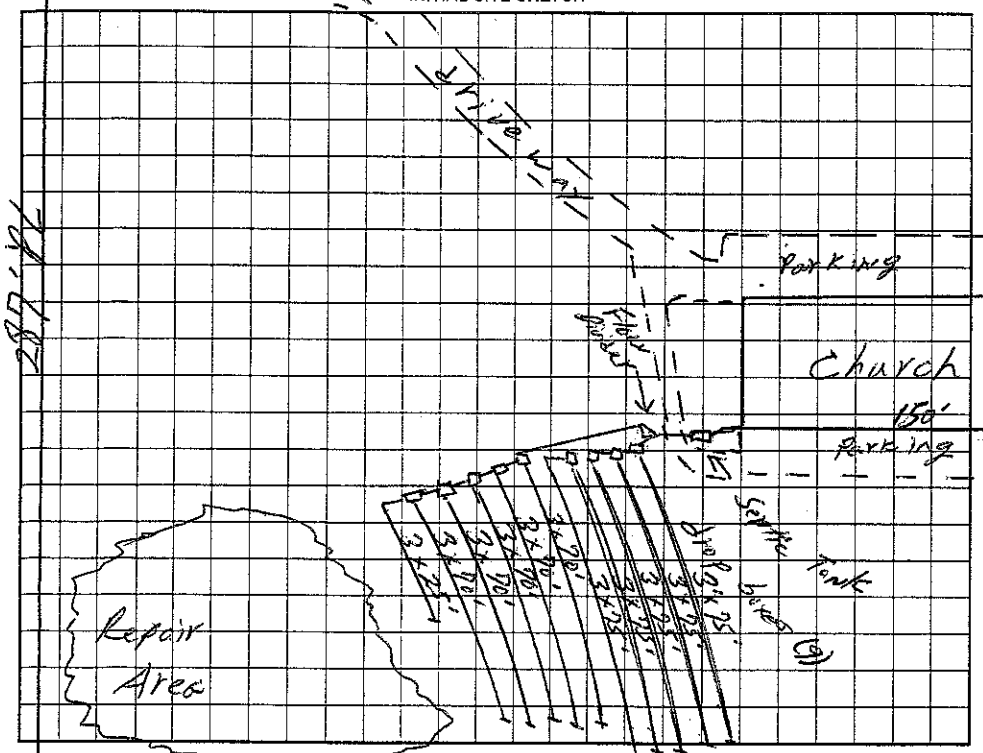

(Not to Scale)

AS BUILT SKETCH

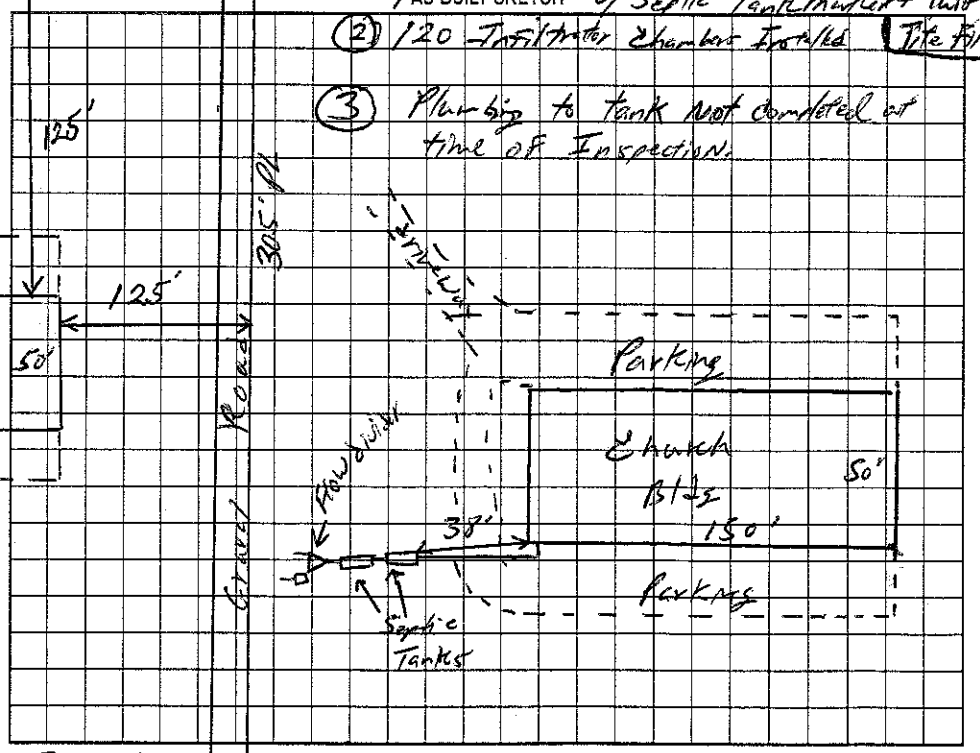

① Installed two (2) 1,000 gal Tanks 5-16-03 STB - 1012 on both tanks.

② 120 Infiltrator Chambers Installed w/ Septic Tank Marker + Tuff-Tite Filter.

③ Plumbing to tank not completed at time of Inspection.

Permit can be suspended or revoked if any false information is supplied toward securing the permit/any unauthorized changes are made to the site/any unauthorized changes are made in the installation of the system. Improvement Permit with plat valid without expiration. Improvement Permit with site plan valid for sixty months. Authorization to Construct is valid for a period equal to that of Improvement Permit – not to exceed sixty months.

Signed: 11/13/02 Rev Robert Johnson date

Improvement Permit by: William O. Johnson date 11/13/02

Authorization to Construct by: William O. Johnson date 11/13/02

Installed by: Tommy Frye

Operation Permit by: William O. Johnson date 11/14/03

Existing System Inspection by: date

HEALTH DEPT. COPY: WHITE OWNER COPY (FINAL): YELLOW OWNER COPY (INITIAL): PINK