IREDELL COUNTY HEALTH DEPARTMENT

This permit voids permit dated 8/15/02. CI

STATESVILLE 704-878-5305 MOORESVILLE 704-664-5281

IMPROVEMENT PERMIT / AUTHORIZATION TO CONSTRUCT / OPERATION PERMIT / EXISTING SYSTEM INSPECTION

PERMIT# 104206 PIN# 4715-08-1200 DATE 6/19/03

OWNER OR CONTRACTOR Allied Partners LLC PHONE: Business (704) 871-1536 Home (704) 876-8600

ADDRESS 310 Treebark Road Statesville N.C. 28625

LOCATION Hwy 90 West, @ Oak Village Point on right before Heartwood Lane

SUBDIVISION Village Point BLOCK / SECTION — LOT 25 LOT AREA 1.01 Ac SITE CLASS PS DESIGN FLOW 480 L.T.A.R. .30 gpd/ft²

Septic Tank: 1,000 Gallons; STB 10 12 Date 1-5-03

Pump Tank: Gallons; PT Date

Pump Make: Model Serial No.

Nitrification Field: No Fields 1 Square Feet 1,600 Linear Feet 535

No Lines 5 (Five) Trench Width 36" Max Trench Bottom Depth 30" Gravel Depth 12"

☒ New System ☐ Repair System Type: I (II, III, IV, V, VI)

System Description: Gravity, Conventional

Repair System Description: Gravity, 25% Reduction

Maintenance Agreement Required: ☐ Yes ☐ No

☐ House/Mod. Home ☒ Mobile Home ☐ Business ☐ Other

No. Bedrooms 4 No. Bathrooms 2 No. Employees


Water Supply: ☐ Individual ☒ Public ☐ Community

☐ Slab ☒ Crawl Space ☐ Basement w/plumbing ☐ Basement wo/plumbing


Comments:/Conditions: ① Install Lines on Contour ② Do Not install when wet

Comments:/Conditions: - Taft-Tite Filter Installed

INITIAL SITE SKETCH

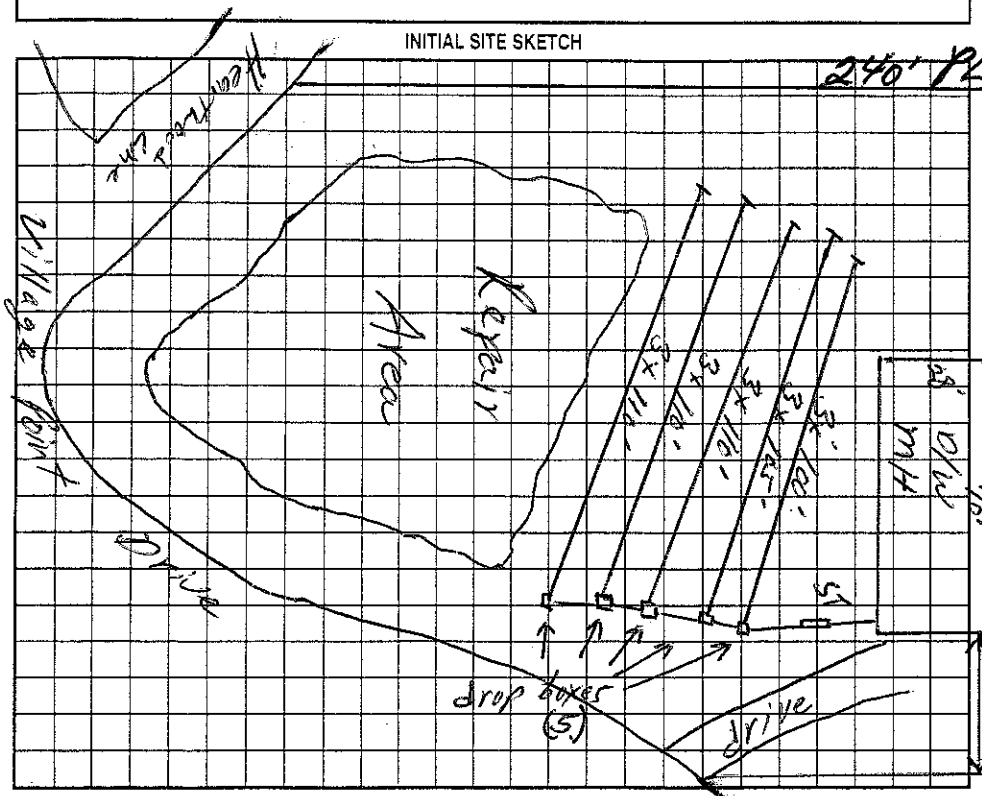

AS BUILT SKETCH

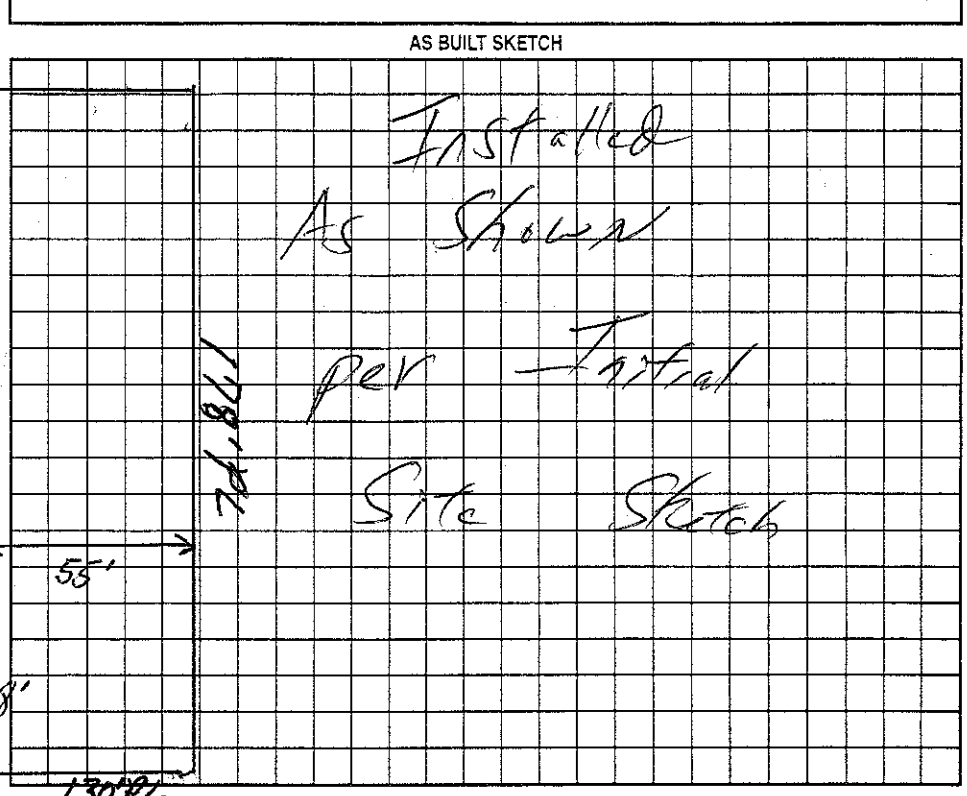

Permit can be suspended or revoked if any false information is supplied toward securing the permit/any unauthorized changes are made to the site/any unauthorized changes are made in the installation of the system. Improvement Permit with plat valid without expiration. Improvement Permit with site plan valid for sixty months. Authorization to Construct is valid for a period equal to that of Improvement Permit – not to exceed sixty months.

Signed: [signature] date 6-20-03 Installed by: Craig Thompson

Improvement Permit by: William O. Johnson date

Operation Permit by: William O. Johnson date 7/14/03

Authorization to Construct by: William O. Johnson date

Existing System Inspection by: date

HEALTH DEPT. COPY: WHITE OWNER COPY (FINAL): YELLOW OWNER COPY (INITIAL): PINK