IREDELL COUNTY HEALTH DEPARTMENT

STATESVILLE 704-878-5305 MOORESVILLE 704-664-5281

IMPROVEMENT PERMIT / AUTHORIZATION TO CONSTRUCT / OPERATION PERMIT / EXISTING SYSTEM INSPECTION

PERMIT# 095498 PIN# 4705988127 DATE 4/20/01

OWNER OR CONTRACTOR Richard Martin PHONE: Business (704) 872-0179 Home

ADDRESS % 1270 Northside Drive Statesville N.C. 28625

LOCATION

SUBDIVISION Village Point BLOCK / SECTION I LOT 27 LOT AREA .57 Ac. SITE CLASS 45 DESIGN FLOW 360 L.T.A.R. .3

Septic Tank: 1,000 Gallons; STB 1012 Date 2-28-01
Pump Tank: Gallons; PT Date
Pump Make: Model Serial No.
Nitrification Field: No Fields 1 Square Feet 1,200 Linear Feet 400
No Lines 4 Trench Width 36" Max Trench Bottom Depth 30" Gravel Depth 12"

X New System ☐ Repair System Type: I (II) III IV V VI
System Description: Gravity, Conventional
Repair System Description: Pump, 50% Reduction
Maintenance Agreement Required: ☐ Yes X No

☐ House/Mod. Home No. Bedrooms 3
X Mobile Home No. Bathrooms 2
☐ Business No. Employees
☐ Other


☐ Slab X Crawl Space ☐ Basement w/plumbing ☐ Basement wo/plumbing

Water Supply: ☐ Individual X Public ☐ Community

Comments/Conditions: (1) Install lines on contour
(2) Keep 10ft from property lines

Comments/Conditions: - Poly Ish Filter Installed
- Septic Tank Riser Installed

INITIAL SITE SKETCH 1" = 40' → Scale

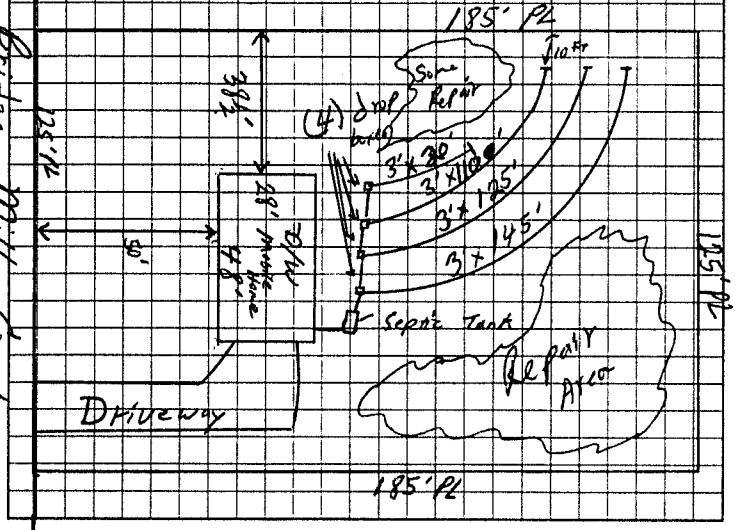

AS BUILT SKETCH

Installed as shown on Initial Site Sketch

Permit can be suspended or revoked if any false information is supplied toward securing the permit/any unauthorized changes are made to the site/any unauthorized changes are made in the installation of the system. Improvement Permit with plat valid without expiration. Improvement Permit with site plan valid for sixty months. Authorization to Construct is valid for a period equal to that of Improvement Permit – not to exceed sixty months.

Signed: Steve Lyle date 4-20-01 Installed by: A-1 Backhoe

Improvement Permit by: William A Johnson RSI date 4/20/01 Operation Permit by: William A Johnson RSI date 4/27/01

Authorization to Construct by: William A Johnson RSI date 4/20/01 Existing System Inspection by: date

HEALTH DEPT COPY WHITE OWNER COPY (FINAL) YELLOW OWNER COPY (INITIAL) PINK