PD# 125.00 * This permit void IP issued 12/31/00.

IREDELL COUNTY HEALTH DEPARTMENT

STATESVILLE 704-878-5305 MOORESVILLE 704-664-5281

IMPROVEMENT PERMIT / AUTHORIZATION TO CONSTRUCT / OPERATION PERMIT / EXISTING SYSTEM INSPECTION

DATE 7/12/01

PERMIT# 93641 PIN# 4705988127

OWNER OR CONTRACTOR Family Value Homes PHONE: Business 799-1560 Home

ADDRESS 2880 Charlotte Hwy Mooresville, N.C. 28117

LOCATION Hwy 90 N, L Village Pt on Right

SUBDIVISION Village Pt BLOCK / SECTION LOT 28 LOT AREA .57 Ac. SITE CLASS PS DESIGN FLOW 480 L.T.A.R. .30

Septic Tank: 4,000 Gallons: STB 1012 Date 4-24-01

Pump Tank: Gallons: PT Date

Pump Make: Model Serial No.

Nitrification Field: No Fields 1 Square Feet 1600' Linear Feet 400'

No Lines 4 @ 100' Trench Width 36" Max Trench Bottom Depth 36" Gravel Depth -

[X] New System [ ] Repair System Type: I, II, III, IV, V, VI

System Description: Gravity, Conventional

Repair System Description:

Maintenance Agreement Required: [ ] Yes [X] No

[ ] House/Mod. Home [X] Mobile Home [ ] Business [ ] Other

No. Bedrooms 4 No. Bathrooms No. Employees


[ ] Slab [X] Crawl Space [ ] Basement w/plumbing [ ] Basement wo/plumbing

Water Supply: [ ] Individual [X] Public [ ] Community


Comments/Conditions: ① Install 25% Reduction System - 67 chambers or 40 - 10' HDPE Sections

Comments/Conditions: - Installed Infiltrator Chambers
- Septic Tank marker Installed
- Poly Lok Filter Installed

INITIAL SITE SKETCH

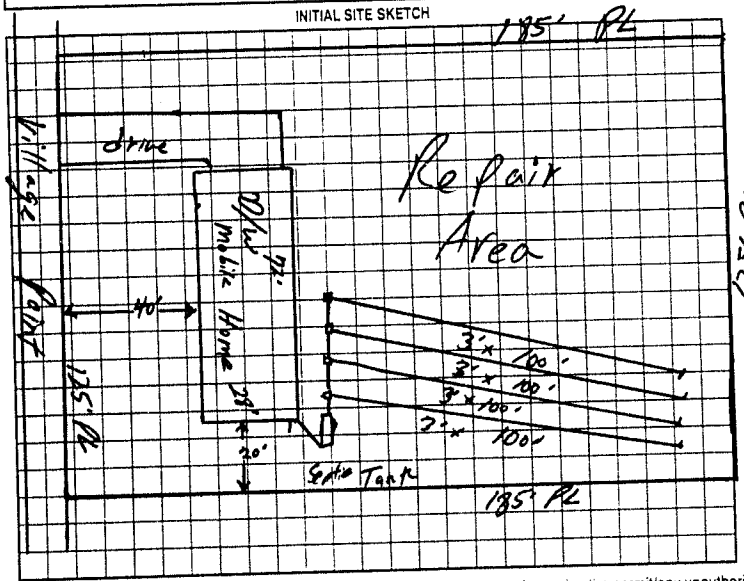

AS BUILT SKETCH

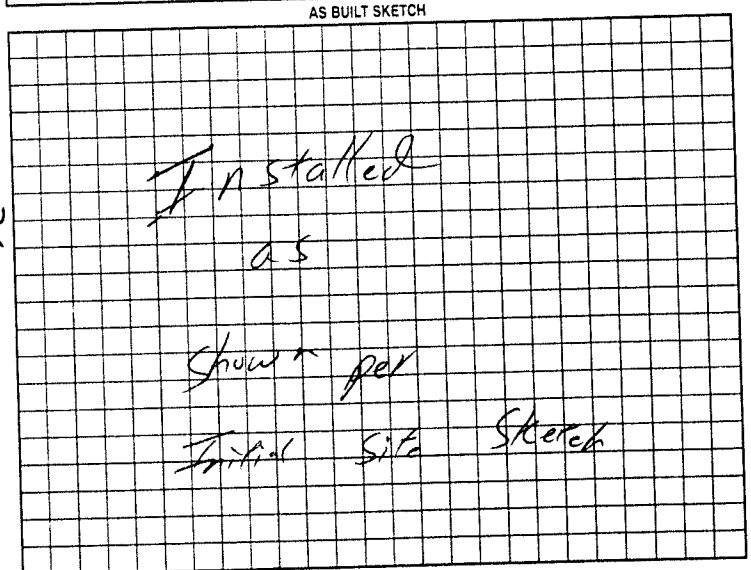

Permit can be suspended or revoked if any false information is supplied toward securing the permit/any unauthorized changes are made to the site/any unauthorized changes are made in the installation of the system. Improvement Permit with plat valid without expiration. Improvement Permit with site plan valid for sixty months. Authorization to Construct is valid for a period equal to that of Improvement Permit – not to exceed sixty months.

Signed: date 7/12/01

Improvement Permit by: William O. Johnson date 7/12/01

Authorization to Construct by: William O. Johnson date 7/12/01

Installed by: A-1 Back hoe

Operation Permit by: William O. Johnson date 7/18/01

Existing System Inspection by: date

HEALTH DEPT. COPY WHITE OWNER COPY (FINAL) YELLOW OWNER COPY (INITIAL) PINK