IREDELL COUNTY HEALTH DEPARTMENT

STATESVILLE 704-878-5305 MOORESVILLE 704-664-5281

IMPROVEMENT PERMIT / AUTHORIZATION TO CONSTRUCT / OPERATION PERMIT / EXISTING SYSTEM INSPECTION

PERMIT# 091593 PIN# 4705988127 (pt.) DATE October 9, 2000

OWNER OR CONTRACTOR Allied Partners PHONE Business 871-1536 Home

ADDRESS 310 Treebank Rd. Statesville

LOCATION 90 West TL just past Griffin HVAC onto Village Pt. Drive on left past jct w/ Bridge Mill Ct.

SUBDIVISION Village Point BLOCK / SECTION LOT 34 LOT AREA .6 ac SITE CLASS PS DESIGN FLOW 360 gpd L.T.A.R. .25-.3

Septic Tank: 1000 Gallons: STB 1012 Date 7-12-02
Pump Tank: Gallons: PT Date
Pump Make: Model Serial No
Nitrification Field: No Fields 1 Square Feet 960 Linear Feet 320
No Lines 4 @ 80' Trench Width 36" Trench Bottom Depth 36"

~~New System~~ Repair System Type: I II III IV V VI
System Description: Geary Innovative - 25% Red
Repair System Description: ~~Same~~ 50% Red
Maintenance Agreement Required: Yes ~~No~~
Gravel Depth NA
Slab ~~Crawl Space~~ Basement w/plumbing Basement wo/plumbing


~~House/Mod Home~~ No Bedrooms 3
Mobile Home No Bathrooms 2
Business No Employees
Other

Water Supply: Individual ~~Public~~ Community


Comments/Conditions:

Comments/Conditions: -Septic Tank Marker, Tuff-Tite Filter Installed -E-Z Lay Installed

INITIAL SITE SKETCH

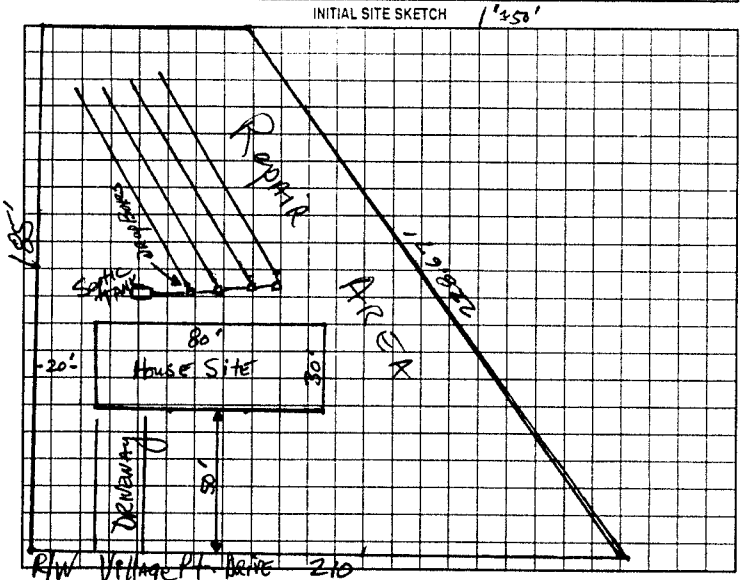

AS BUILT SKETCH

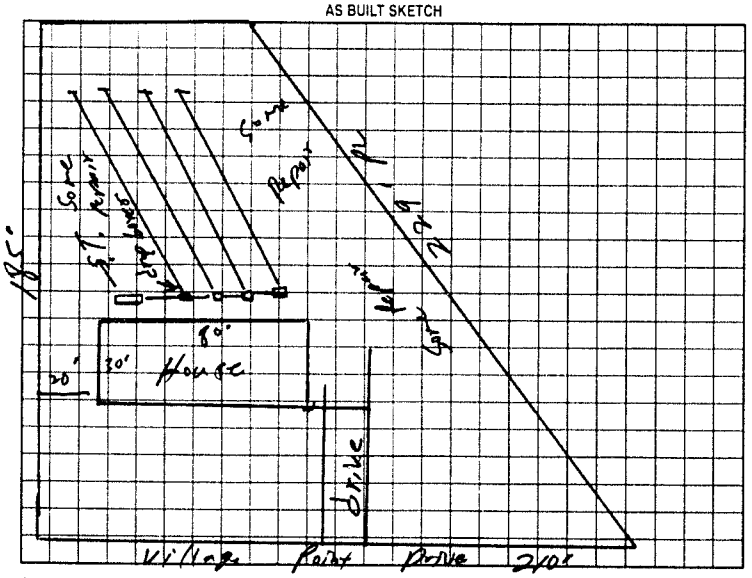

Permit can be suspended or revoked if any false information is supplied toward securing the permit/any unauthorized changes are made to the site/any unauthorized changes are made in the installation of the system. Improvement Permit with plat valid without expiration. Improvement Permit with site plan valid for sixty months. Authorization to Construct is valid for a period equal to that of Improvement Permit – not to exceed sixty months.

Signed: date

Improvement Permit by: date 10-9-00

Authorization to Construct by: date 10-23-02

Installed by: A1 Backhoe

Operation Permit by: William O Johnson date 9/30/02

Existing System Inspection by: date

HEALTH DEPT COPY WHITE OWNER COPY (FINAL) YELLOW OWNER COPY (INITIAL) PINK