This permit voids permit issued 10/9/00.

IREDELL COUNTY HEALTH DEPARTMENT

STATESVILLE 704-878-5305 OI MOORESVILLE 704-664-5281

IMPROVEMENT PERMIT / AUTHORIZATION TO CONSTRUCT / OPERATION PERMIT / EXISTING SYSTEM INSPECTION

PERMIT# 091592 PIN# 4705 988127 (et) DATE 7/15/02

OWNER OR CONTRACTOR Alfred Partners PHONE Business (704) 871-1536 Home —

ADDRESS 310 Tree Bark Rd Statesville, N.C.

LOCATION 90 west @ Village Point on left corn of of Bridge Mill Ct.

SUBDIVISION Village Point BLOCK / SECTION LOT 33 LOT AREA .57 Ac SITE CLASS PS DESIGN FLOW 480 L.T.A.R. - 30

Septic Tank: 1,000 Gallons: STB 1012 Date 7-9-02
Pump Tank: Gallons: PT Date
Pump Make: Model Serial No
Nitrification Field: No Fields 1 Square Feet 1600 Linear Feet 400
No Lines 3 Trench Width 36" Max Trench Bottom Depth 36" Gravel Depth N/A

X New System Repair System Type I II III IV V VI
System Description: Gravity, 25% Red.
Repair System Description: Gravity, 25% Red.
Maintenance Agreement Required: Yes No

✓ House/Mod. Home No. Bedrooms 4
Mobile Home No. Bathrooms 3
Business No. Employees
Other


Slab X Crawl Space Basement w/plumbing Basement wo/plumbing

Water Supply: Individual ~~Public~~ Community


Comments/Conditions: ① Install Lines on contour

Comments/Conditions: -40- 10ft Section EZflow Installed - Polylok filter + ST. Marker Installed

INITIAL SITE SKETCH

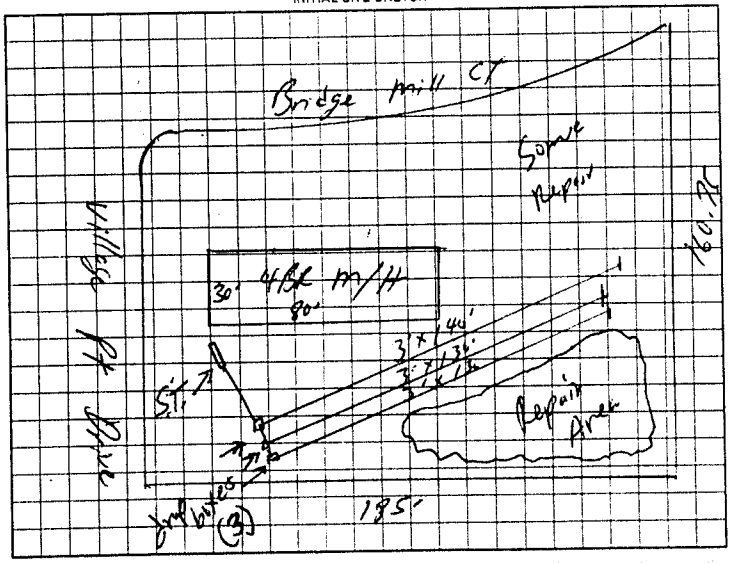

AS BUILT SKETCH

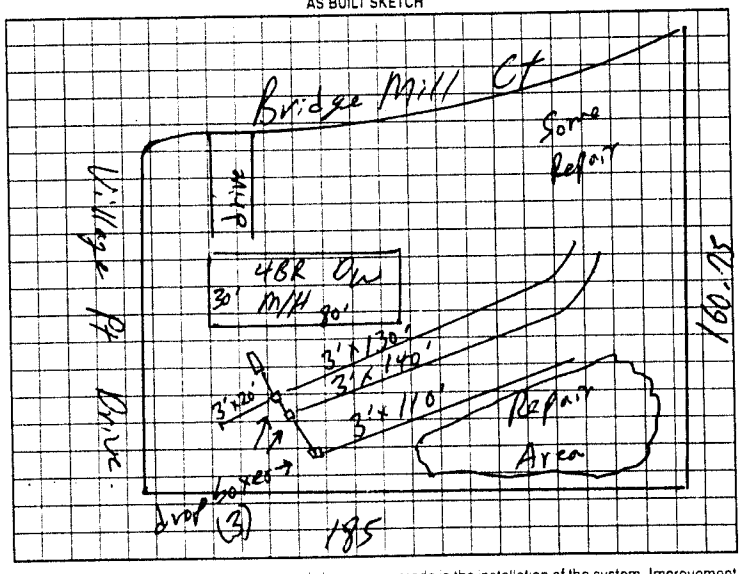

Permit can be suspended or revoked if any false information is supplied toward securing the permit, any unauthorized changes are made to the site, any unauthorized changes are made in the installation of the system. Improvement Permit with plat valid without expiration. Improvement Permit with site plan valid for sixty months. Authorization to Construct is valid for a period equal to that of Improvement Permit – not to exceed sixty months.

Signed: Dennis Dalla date 7-15-02 Installed by A-1 Backhoe

Improvement Permit by: William O. Johnson date 7/15/02 Operation Permit by William O. Johnson date 7/23/02

Authorization to Construct by: William O. Johnson date 7/15/02 Existing System Inspection by date

HEALTH DEPT COPY WHITE OWNER COPY (FINAL) YELLOW OWNER COPY (INITIAL) PINK