This permit voids previously issues permit dated 10/28/02.

IREDELL COUNTY HEALTH DEPARTMENT

STATESVILLE 704-878-5305 CI MOORESVILLE 704-664-5281

IMPROVEMENT PERMIT / AUTHORIZATION TO CONSTRUCT / OPERATION PERMIT / EXISTING SYSTEM INSPECTION

PERMIT# 104209 PIN# 4715-08-8156 DATE 2/19/04

OWNER OR CONTRACTOR Allied Partners PHONE: Business (704) 876-8600 Home

ADDRESS 310 Treebark Rd Statesville N.C. 28625

LOCATION Hwy 90W (L) on Village Point (L) Bridge Point 2nd lot on Right @ Cul-de-sac

SUBDIVISION Village Point BLOCK / SECTION – LOT 35 LOT AREA .67 Ac. SITE CLASS. PS DESIGN FLOW 480 L.T.A.R. .36

Septic Tank: 1000 Gallons; STB 1012 Date 3-26-04

Pump Tank: Gallons; PT Date

Pump Make: Model Eng to Serial No.

Nitrification Field: No Fields 1 Square Feet Eng to 600 Linear Feet 400

No Lines 3 Trench Width 36" Max Trench Bottom Depth 32" Gravel Depth N/A

☒ New System ☐ Repair System Type: I, II, (III), IV, V, VI

System Description: Gravity, 25% Reduction

Repair System Description: Gravity, 25% Reduction

Maintenance Agreement Required: ☐ Yes ☒ No

☐ House/Mod. Home ☒ Mobile Home ☐ Business ☐ Other

No. Bedrooms 4 No. Bathrooms No. Employees

☐ Slab ☒ Crawl Space ☐ Basement w/plumbing ☐ Basement wo/plumbing


Water Supply: ☐ Individual ☒ Public ☐ Community

Comments:/Conditions:

Comments:/Conditions:

- Polylok Filter + S.T. Marker Installed
- 64 Infiltrator Chambers Installed

INITIAL SITE SKETCH

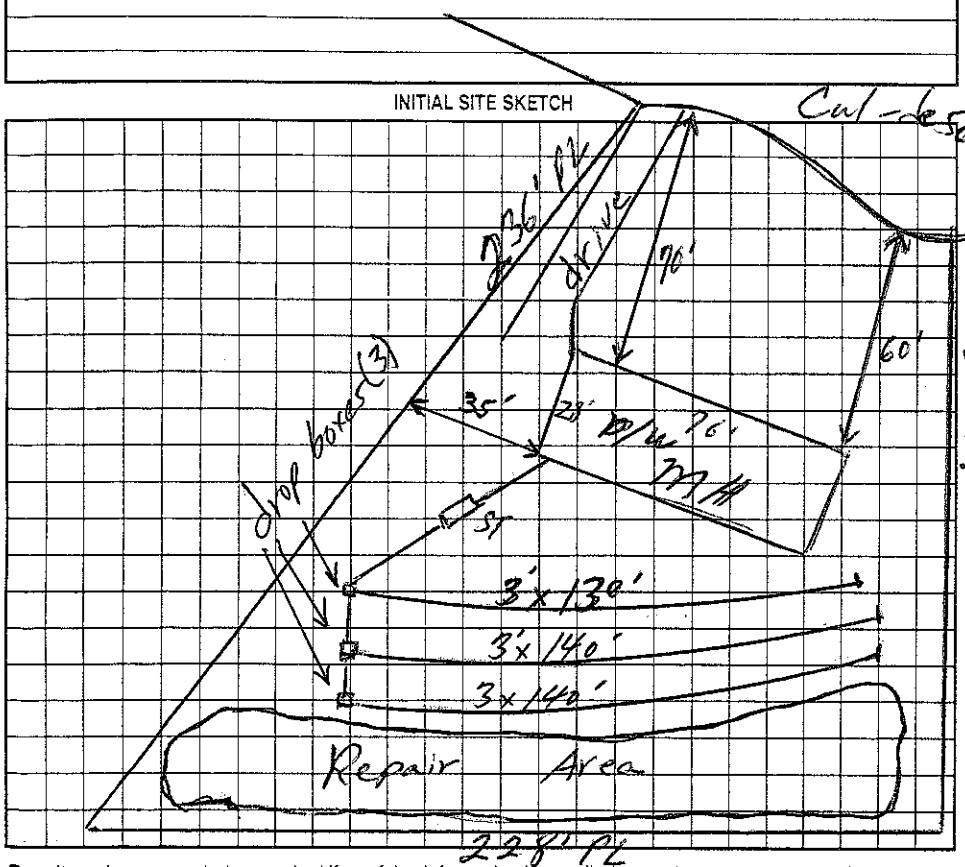

AS BUILT SKETCH

Installed As Shown

per Initial

Site Sketch

Permit can be suspended or revoked if any false information is supplied toward securing the permit/any unauthorized changes are made to the site/any unauthorized changes are made in the installation of the system. Improvement Permit with plat valid without expiration. Improvement Permit with site plan valid for sixty months. Authorization to Construct is valid for a period equal to that of Improvement Permit – not to exceed sixty months.

Signed: date

Improvement Permit by: William O. Johnson date 2/19/04

Authorization to Construct by: William O. Johnson date 2/19/04

Installed by: Craig Thompson

Operation Permit by: William O. Johnson date 8/24/04

Existing System Inspection by: date

HEALTH DEPT. COPY: WHITE OWNER COPY (FINAL): YELLOW OWNER COPY (INITIAL): PINK