IREDELL COUNTY HEALTH DEPARTMENT

STATESVILLE 704-878-5305 MOORESVILLE 704-664-5281

IMPROVEMENT PERMIT / AUTHORIZATION TO CONSTRUCT / OPERATION PERMIT / EXISTING SYSTEM INSPECTION

PERMIT# 104208 PIN# 4715-68-~~2622~~8430 DATE 4/15/03

OWNER OR CONTRACTOR Allied Partners PHONE: Business (704) 871-1536 Home

ADDRESS 310 Tree bark Rd Statesville N.C. 28625

LOCATION Hwy 90 W @ Village Point Corner of Bridge Mill Ct

SUBDIVISION Village Point BLOCK / SECTION — LOT 32 LOT AREA .555 Ac SITE CLASS. 75 DESIGN FLOW 360 L.T.A.R.

Septic Tank: 1,000 Gallons; STB 1012 Date 8-23-02
Pump Tank: Gallons; PT Date
Pump Make: Model Equa to Serial No.
Nitrification Field: No Fields 1 Square Feet 1200 Linear Feet 300
No Lines 4@25 Trench Width 36" Max Trench Bottom Depth 30" Gravel Depth N/A

☒ New System ☐ Repair System Type: I, II, (III), IV, V, VI
System Description: Gravity, 25% Reduction
Repair System Description: Gravity, 25% Reduction
Maintenance Agreement Required: ☐ Yes ☒ No

☐ House/Mod. Home ☒ Mobile Home ☐ Business ☐ Other
No. Bedrooms 3 No. Bathrooms 2 No. Employees


☐ Slab ☒ Crawl Space ☐ Basement w/plumbing ☐ Basement wo/plumbing

Water Supply: ☐ Individual ☒ Public ☐ Community

Comments:/Conditions:

Comments:/Conditions:
- Tuff Tite filter + ST marker Installed
- 48 Infiltrator Chambers Installed

INITIAL SITE SKETCH

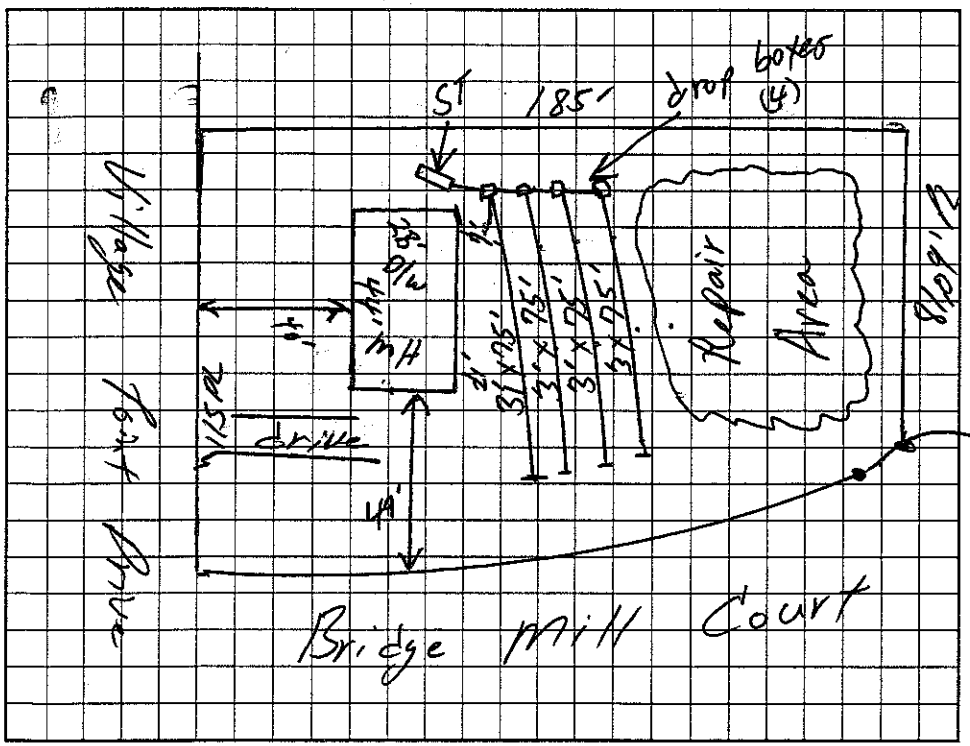

AS BUILT SKETCH

Installed as Shown per Initial Site Sketch

Permit can be suspended or revoked if any false information is supplied toward securing the permit/any unauthorized changes are made to the site/any unauthorized changes are made in the installation of the system. Improvement Permit with plat valid without expiration. Improvement Permit with site plan valid for sixty months. Authorization to Construct is valid for a period equal to that of Improvement Permit – not to exceed sixty months.

Signed: Dennis Dalliker date 4/15/03 Installed by: A-1 Backhoe

Improvement Permit by: William O. Johnson date 4/15/03 Operation Permit by: William O. Johnson date 4/16/03

Authorization to Construct by: William O. Johnson date 4/15/03 Existing System Inspection by: date

HEALTH DEPT. COPY: WHITE OWNER COPY (FINAL): YELLOW OWNER COPY (INITIAL): PINK

IREDELL COUNTY HEALTH DEPARTMENT

STATESVILLE 704-878-5305 MOORESVILLE 704-664-5281

IMPROVEMENT PERMIT / AUTHORIZATION TO CONSTRUCT / OPERATION PERMIT / EXISTING SYSTEM INSPECTION

PERMIT# 104208 PIN# 4715-08-~~2672~~-8430 DATE 4/15/03

OWNER OR CONTRACTOR Allied Partners PHONE: Business (704) 871-1536 Home —

ADDRESS 310 Tree bark Rd Statesville N.C. 28625

LOCATION Hwy 90 W @ Village Point Corner of Bridge Mill Ct

SUBDIVISION Village Point BLOCK / SECTION — LOT 32 LOT AREA .555 Ac SITE CLASS. PS DESIGN FLOW 360 L.T.A.R.

Septic Tank: 1,000 Gallons; STB 1012 Date 8-23-02
Pump Tank: Gallons; PT Date
Pump Make: Model Equa to Serial No.
Nitrification Field: No Fields 1 Square Feet 1200 Linear Feet 300
No Lines 4@25 Trench Width 36" Max Trench Bottom Depth 30" Gravel Depth NA

☒ New System ☐ Repair System Type: I, II, III, IV, V, VI
System Description: Gravity, 25% Reduction
Repair System Description: Gravity, 25% Reduction
Maintenance Agreement Required: ☐ Yes ☒ No

☐ House/Mod. Home ☒ Mobile Home ☐ Business ☐ Other
No. Bedrooms 3 No. Bathrooms 2 No. Employees


☐ Slab ☒ Crawl Space ☐ Basement w/plumbing ☐ Basement wo/plumbing

Water Supply: ☐ Individual ☒ Public ☐ Community

Comments:/Conditions:

Comments:/Conditions:
- Tuff Tite filter + ST marker Installed.
- 48 Infiltrator Chamber Installed

INITIAL SITE SKETCH

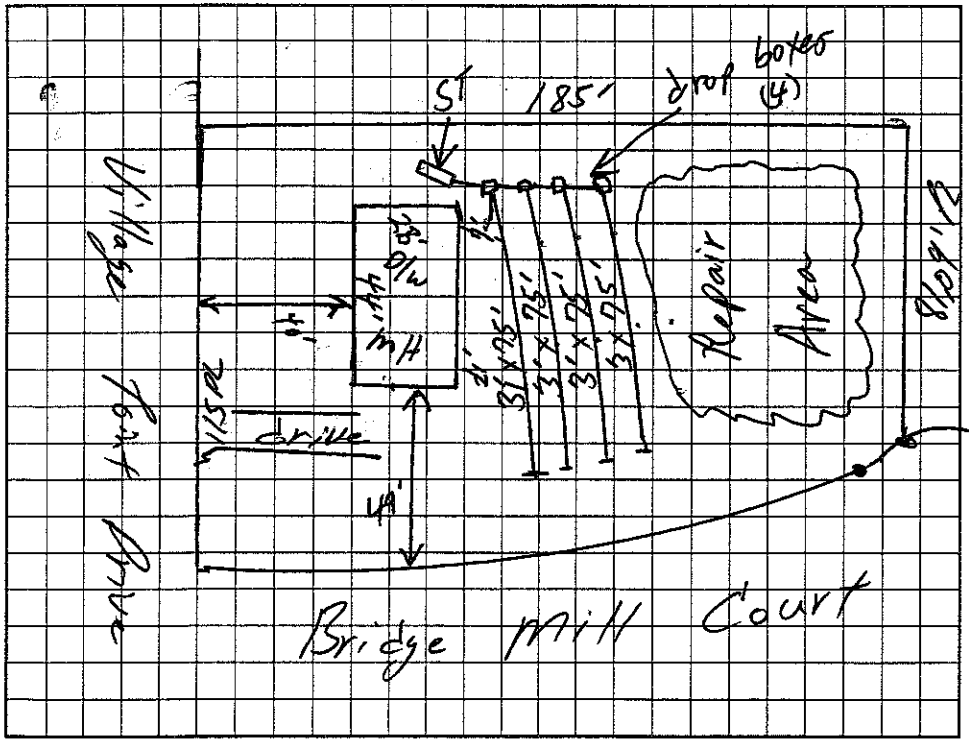

AS BUILT SKETCH

Installed as shown per Initial Site Sketch

Permit can be suspended or revoked if any false information is supplied toward securing the permit/any unauthorized changes are made to the site/any unauthorized changes are made in the installation of the system. Improvement Permit with plat valid without expiration. Improvement Permit with site plan valid for sixty months. Authorization to Construct is valid for a period equal to that of Improvement Permit – not to exceed sixty months.

Signed: Dennis Dalliker date 4/15/03 Installed by: A-1 Backhoe

Improvement Permit by: William O. Johnson date 4/15/03 Operation Permit by: William O. Johnson date 4/16/03

Authorization to Construct by: William O. Johnson date 4/15/03 Existing System Inspection by: date

HEALTH DEPT. COPY: WHITE OWNER COPY (FINAL): YELLOW OWNER COPY (INITIAL): PINK